


OWNER: Bert Salisbury (Renter) MAILING ADDRESS: Rt. 2, Box 367

LOCATION OF WELL: Owner's No. #1 CITY AND STATE: Coburg, Oregon

SW 1/4 SE 1/4 Sec. 32 T. 16 S., R. 3 W., W.M.

Bearing and distance from section or subdivision corner Well bears S. 16° 52' W. 1,448' from the SE cor. of the Manawweather Brown DLC

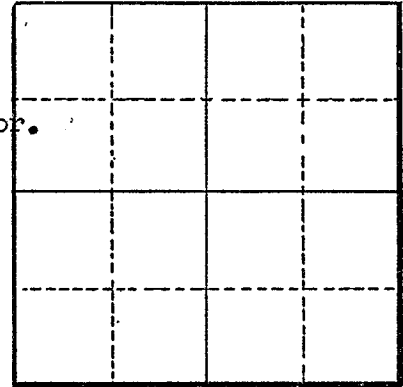

Section

Altitude at well

TYPE OF WELL: driven Date Constructed 1952

Depth drilled 21 Depth cased 21

CASING RECORD:

4-inch

FINISH:

1/2" holes 4" apart from 18 to 21

AQUIFERS:

Loam, gravel

WATER LEVEL:

16-feet

PUMPING EQUIPMENT: Type Fairbanks-Morse-Centrifugal H.P. 20  
Capacity 400 G.P.M.

WELL TESTS:

Drawdown 2 ft. after hours Pumping 300 G.P.M.  
Drawdown ft. after hours G.P.M.

USE OF WATER irrigation Temp. °F., 19

SOURCE OF INFORMATION GR-2645

DRILLER or DIGGER

ADDITIONAL DATA:  
Log X Water Level Measurements Chemical Analysis Aquifer Test

REMARKS:

Sandy loam 4 4  
Coarse gravel 15 19  
Pea Gravel 2 21