

STATE ENGINEER  
Salem, Oregon

**LANE**  
7640

# Well Record

GR- 949

STATE WELL NO. 16/3W-32R(1)  
COUNTY Lane  
APPLICATION NO. GR- 979

OWNER: Green Brothers


MAILING ADDRESS: Box 72

LOCATION OF WELL: Owner's No. #8

CITY AND STATE: Coburg, Oregon

SE 1/4 SE 1/4 Sec. 32 T. 16 S., R. 3 W., W.M.

Bearing and distance from section or subdivision corner S13°40'E. 1428' from the E 1/4 cor. Sec. 25.

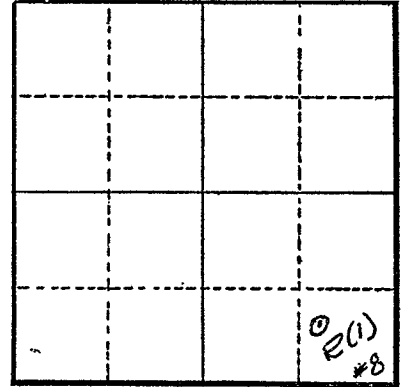

Section 32

Altitude at well 390 ft.

TYPE OF WELL: Dug Date Constructed 1926

Depth drilled 18 ft. Depth cased 18 ft.

### CASING RECORD:

Open hole	0 to 6 ft.
Concrete	6 to 18 ft.

### FINISH:

### AQUIFERS:

### WATER LEVEL:

12 ft.

PUMPING EQUIPMENT: Type 4" x 3" Centrifugal H.P. 20  
Capacity 400 G.P.M.

### WELL TESTS:

Drawdown	4	ft. after	hours	400	G.P.M.
Drawdown		ft. after	hours		G.P.M.

USE OF WATER Irrigation Temp. °F. 19

SOURCE OF INFORMATION G.R. Record

DRILLER or DIGGER

### ADDITIONAL DATA:

Log Water Level Measurements Chemical Analysis Aquifer Test

### REMARKS:

Log: Medium gravel	0 to 6 ft.
Pea gravel	6 to 18 ft.

Irrigation of 40 acres.