

LANE  
7653

# Well Record

STATE WELL NO. 16/3W-33N (1)  
COUNTY Lane  
APPLICATION NO. GR-450

OWNER: Edith Hurd


MAILING ADDRESS:

LOCATION OF WELL: Owner's No. #2

CITY AND STATE: Harrisburg, Ore.

SW 1/4 SW 1/4 Sec. 33 T. 16 S., R. 3 W., W.M.

Bearing and distance from section or subdivision corner 1,142 ft. S. 39°04' E. from N.W. cor. of Jacob Spores DLC

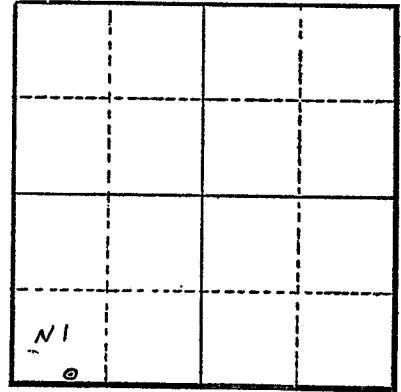

Section 33

Altitude at well 375

TYPE OF WELL: dug Date Constructed 1948

Depth drilled 20 Depth cased 20

### CASING RECORD:

44 inch concrete

### FINISH:

### AQUIFERS:

### WATER LEVEL:

16

PUMPING EQUIPMENT: Type Fairbanks Morse 3" X 4" H.P. 20  
Capacity 400 G.P.M.

### WELL TESTS:

Drawdown 0 ft. after hours 400 G.P.M.  
Drawdown ft. after hours G.P.M.

USE OF WATER irrigation - 32 Ac. Temp. °F. 19

SOURCE OF INFORMATION GR-450

DRILLER or DIGGER ---

### ADDITIONAL DATA:

Log \* Water Level Measurements Chemical Analysis Aquifer Test

### REMARKS:

\*Chehalis loam-----0 to 12 ft.  
Water bearing gravel---12 to 20 ft.