

LANE
7654

Well Record

OWNER: Lee B. Thomas


MAILING ADDRESS: Rt. 2, Box 346

LOCATION OF WELL: Owner's No. 1

CITY AND STATE: Eugene, Ore.

SW 1/4 SW 1/4 Sec. 33 T. 16 S., R. 3 W., W.M.

Bearing and distance from section or subdivision
corner 1281 ft. E. & 186 ft. N. from N.W. corner
of D.L.C. #45

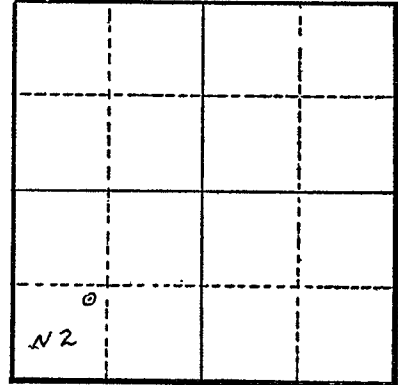

Section 33

Altitude at well 390

TYPE OF WELL: driven Date Constructed April 2, '41

Depth drilled 20 Depth cased 20

CASING RECORD:

3 inch

FINISH:

AQUIFERS:

WATER LEVEL:

10 ft.

PUMPING EQUIPMENT: Type Fairbanks Morse H.P. 7 1/2
Capacity 110 G.P.M.

WELL TESTS:

Drawdown 4 ft. after 190 hours G.P.M.
Drawdown ft. after hours G.P.M.

USE OF WATER irrigation - 5.5 Ac. Temp. °F., 19

SOURCE OF INFORMATION GR-581

DRILLER or DIGGER ----

ADDITIONAL DATA:

Log ---- Water Level Measurements ---- Chemical Analysis ---- Aquifer Test ----

REMARKS: