

STATE ENGINEER
Salem, Oregon

LANE
7655


Well Record

STATE WELL NO. 16/3W-33P (1)
COUNTY Lane
APPLICATION NO. GR-450

OWNER: Edith Hurd
MAILING ADDRESS:

LOCATION OF WELL: Owner's No. #1
CITY AND STATE: Harrisburg, Ore.

SE 1/4 SW 1/4 Sec. 33 T. 16 N S, R. 3 E W., W.M.
Bearing and distance from section or subdivision
corner 1537 ft. S. 15° 28' E. from N.W. cor. of
Jacob Spores DLG

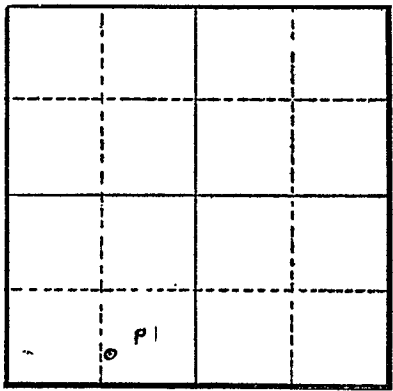

Section 33

Altitude at well 407

TYPE OF WELL: driven Date Constructed 1932

Depth drilled 20 Depth cased 20

CASING RECORD:

3 2 inch pipes

FINISH:

AQUIFERS:

WATER LEVEL:

16

PUMPING EQUIPMENT: Type Fairbanks Morse 2 1/2" X 3" H.P. 15
Capacity 300 G.P.M.

WELL TESTS:

Drawdown 1/4 inch ft. after hours 375 G.P.M.
Drawdown ft. after hours G.P.M.

USE OF WATER irrigation - 11 Ac. Temp. °F., 19

SOURCE OF INFORMATION GR-450

DRILLER or DIGGER ----

ADDITIONAL DATA:

Log No. Water Level Measurements Chemical Analysis Aquifer Test

REMARKS: