

STATE ENGINEER
Salem, Oregon

LANE
7658

Well Record

STATE WELL NO. 16/3W-33M
COUNTY LANE
APPLICATION NO. GR-2341

OWNER: C. W. Pitkin

MAILING
ADDRESS:

Rt. 2, Box 344 A

LOCATION OF WELL: Owner's No. #2


CITY AND
STATE:

Eugene, Oregon

NW 1/4 SW 1/4 Sec. 33 T. 16 N. S., R. 3 E. W., W.M.

Bearing and distance from section or subdivision

corner N. 64° 0' E. 1790'

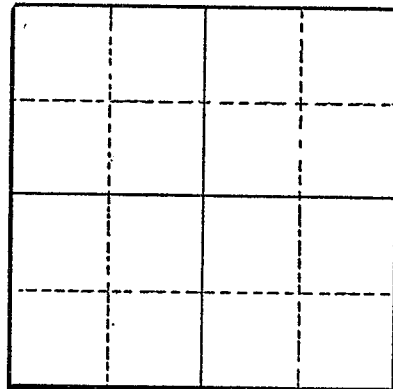

Section

Altitude at well

TYPE OF WELL: Dug Date Constructed 1935

Depth drilled 16 Depth cased 16

CASING RECORD:

42-inch

FINISH:

AQUIFERS:

Sand, gravel and boulders

WATER LEVEL:

8-feet

PUMPING EQUIPMENT: Type Allis Chalmers

H.P. 15

Capacity 240 G.P.M.

WELL TESTS:

Drawdown 3 ft. after hours Pumping 240 G.P.M.

Drawdown ft. after hours G.P.M.

USE OF WATER Irrigation

Temp. °F. 19

SOURCE OF INFORMATION GR-2225

DRILLER or DIGGER

ADDITIONAL DATA:

Log Water Level Measurements Chemical Analysis Aquifer Test

REMARKS:

Sand and gravel, and boulders