

STATE ENGINEER
Salem, Oregon

LANE
7659

Well Record

STATE WELL NO. 16/3W-33M (1)
COUNTY Lane
APPLICATION NO. GR-587

OWNER: Lee B. Thomas


MAILING ADDRESS: Rt. 2, Box 34 b

LOCATION OF WELL: Owner's No. 2

CITY AND STATE: Eugene, Oregon

NW $\frac{1}{4}$ SW $\frac{1}{4}$ Sec. 33 T. 16 ^N S., R. 3 ^E W., W.M.

Bearing and distance from section or subdivision corner 581 ft. N. & then 430 ft. N. 30°37' W.
from point 1097 ft. E. from N.W. cor. J. C.
Spores DIC #45

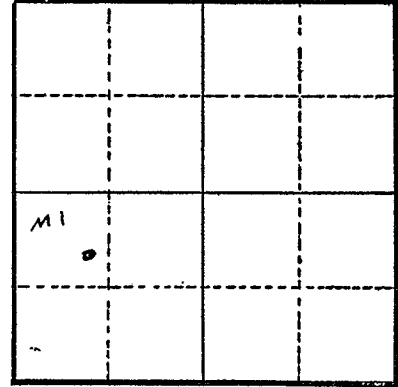

Altitude at well 350

Section 33

TYPE OF WELL: Driven Date Constructed May 2, '41

Depth drilled 20 Depth cased _____

CASING RECORD:

4 inch

FINISH:

AQUIFERS:

WATER LEVEL:

10 ft.

PUMPING EQUIPMENT: Type Allis Chalmer 1 1/2" H.P. 7 1/2
Capacity 110 G.P.M.

WELL TESTS:

Drawdown 4 ft. after _____ hours 190 G.P.M.

Drawdown _____ ft. after _____ hours _____ G.P.M.

USE OF WATER irrigation - 7 ac. Temp. _____ °F., 19

SOURCE OF INFORMATION GR-587

DRILLER or DIGGER _____

ADDITIONAL DATA:

Log _____ Water Level Measurements _____ Chemical Analysis _____ Aquifer Test _____

REMARKS: