

STATE ENGINEER
Salem, Oregon

LANE
7713

Well Record

STATE WELL NO. 16/LW-3 C
COUNTY Lane
APPLICATION NO. GR-3151

OWNER: T. R. Borneman


MAILING ADDRESS: 700 ElRio Lane

LOCATION OF WELL: Owner's No. #1

CITY AND STATE: Junction City, Oregon

NE 1/4 NW 1/4 Sec. 3 T. 16 S., R. 4 W., W.M.

Bearing and distance from section or subdivision corner 1350' E. 425' S.

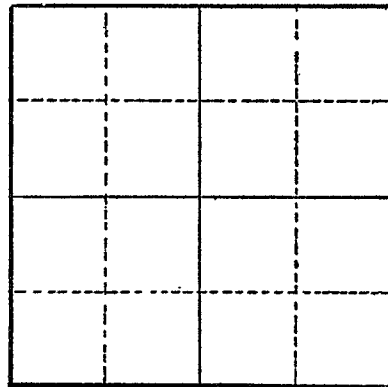

Section

Altitude at well

TYPE OF WELL: Dug Date Constructed 1940

Depth drilled 10' Depth cased 10'

CASING RECORD:

36"

FINISH:

AQUIFERS:

gravel

WATER LEVEL:

7'

PUMPING EQUIPMENT: Type Century H.P. 15
Capacity 350 G.P.M.

WELL TESTS:

Drawdown 4 ft. after hours G.P.M.

Drawdown ft. after hours G.P.M.

USE OF WATER Irrigation Temp. °F., 19

SOURCE OF INFORMATION GR-2952

DRILLER or DIGGER

ADDITIONAL DATA:

Log Water Level Measurements Chemical Analysis Aquifer Test

REMARKS:

gravel