

STATE ENGINEER
Salem, Oregon-

LANE
7714

Well Record

STATE WELL NO. 16/4W-3F
COUNTY Lane
APPLICATION NO. GR-3150

OWNER: T. R. Borneman


MAILING ADDRESS: 700 ElRio Lane

LOCATION OF WELL: Owner's No. #2

CITY AND STATE: Junction City, Oregon

SE 1/4 NW 1/4 Sec. 3 T. 16 S., R. 4W., W.M.

Bearing and distance from section or subdivision corner 1700' E., 1750' S.

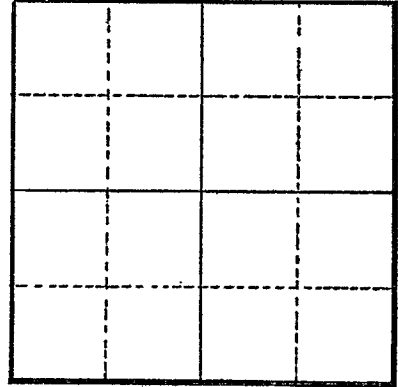

Section

Altitude at well

TYPE OF WELL: Dug Date Constructed 1954

Depth drilled 7' Depth cased 7'

CASING RECORD:

2 1/2"

FINISH:

AQUIFERS:

gravel

WATER LEVEL:

PUMPING EQUIPMENT: Type Century H.P. 15
Capacity 350 G.P.M.

WELL TESTS:

Drawdown ft. after hours G.P.M.

Drawdown ft. after hours G.P.M.

USE OF WATER Irrigation Temp. °F., 19

SOURCE OF INFORMATION GR-2951

DRILLER or DIGGER self

ADDITIONAL DATA:

Log Water Level Measurements Chemical Analysis Aquifer Test

REMARKS:

gravel