

STATE ENGINEER  
Salem, Oregon

**LANE**  
**7716**

# Well Record

STATE WELL NO. 16/4-3M  
COUNTY Lane  
APPLICATION NO. GR-1796

OWNER: Vern Rishell


MAILING ADDRESS: 1739 River Road

LOCATION OF WELL: Owner's No. \_\_\_\_\_

CITY AND STATE: Junction City, Oregon

NW 1/4 SW 1/4 Sec. 3 T. 16 S., R. 4 W., W.M.

Bearing and distance from section or subdivision  
corner 300' S & 5' E from W 1/4 corner Sec 3

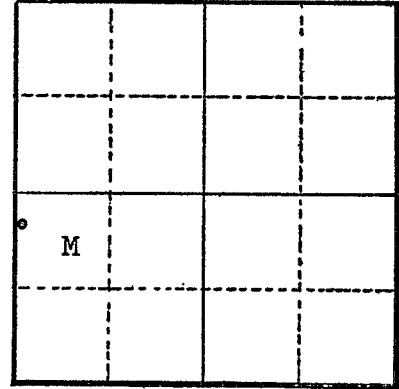

Section 3

Altitude at well 310'

TYPE OF WELL: Driven Date Constructed 2010-49

Depth drilled 19' Depth cased 19'

### CASING RECORD:

4-inch

### FINISH:

Holes in 4' at bottom well

### AQUIFERS:

### WATER LEVEL:

10'

PUMPING EQUIPMENT: Type Jacouski H.P. 5  
Capacity 140 G.P.M.

### WELL TESTS:

Drawdown 2 ft. after \_\_\_\_\_ hours 750 G.P.M.

Drawdown \_\_\_\_\_ ft. after \_\_\_\_\_ hours \_\_\_\_\_ G.P.M.

USE OF WATER Irrigation Temp. \_\_\_\_\_ °F., 19 \_\_\_\_\_

SOURCE OF INFORMATION GR-3995

DRILLER or DIGGER \_\_\_\_\_

### ADDITIONAL DATA:

Log NA Water Level Measurements \_\_\_\_\_ Chemical Analysis \_\_\_\_\_ Aquifer Test \_\_\_\_\_

### REMARKS: