

STATE ENGINEER
Salem, Oregon

LANE
7732

Well Record

STATE WELL NO. 16/LW-4A (1)
COUNTY Lane
APPLICATION NO. GR-642

OWNER: Callie B. Tiffiee

MAILING
ADDRESS:

LOCATION OF WELL: Owner's No.


CITY AND
STATE:

Junction City, Oregon

NE $\frac{1}{4}$ NE $\frac{1}{4}$ Sec. 4 T. 16 S. R. 4 W., W.M.

Bearing and distance from section or subdivision

corner 830.02 ft. S. 66° 09' W. of N.E. cor. Sec. 4

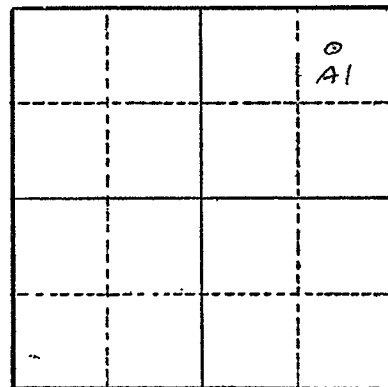

Altitude at well 325 feet Interpolated

TYPE OF WELL: Driven Date Constructed 1951

Depth drilled 26 Depth cased

Section 4

CASING RECORD:

4 inch

FINISH:

AQUIFERS:

WATER LEVEL:

10 ft.

PUMPING EQUIPMENT: Type Centrifugal H.P. 7 $\frac{1}{2}$
Capacity 350 G.P.M.

WELL TESTS:

Drawdown ft. after hours G.P.M.

Drawdown ft. after hours G.P.M.

USE OF WATER irrigation - 20 Ac. Temp. °F. 19

SOURCE OF INFORMATION GR-642

DRILLER or DIGGER Walter Nelson

ADDITIONAL DATA:

Log -- Water Level Measurements Chemical Analysis Aquifer Test

REMARKS: