

STATE ENGINEER
Salem, Oregon

LANE
7733

OBSERVATION WELL
Well Record

STATE WELL NO. 16/LW-4B (1)
COUNTY Lane
APPLICATION NO. GR-639

(JOHN)
OWNER: Einer Hentze


MAILING
ADDRESS: 210 Hentze Lane

LOCATION OF WELL: Owner's No. #1

CITY AND
STATE: Junction City, Ore.

NW 1/4 NE 1/4 Sec. 4 T. 16 N S. R. 4 W., W.M.

Bearing and distance from section or subdivision
corner 2207.17 ft. S. 60° 10' 15" W. of N.E. cor.
sec. 4

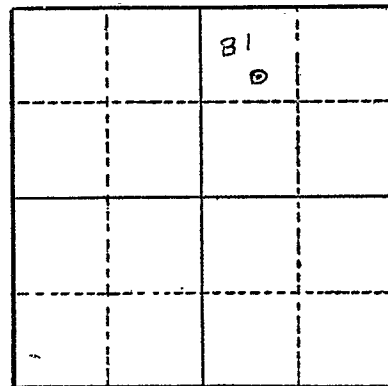

Section 4

Altitude at well

TYPE OF WELL: drilled Date Constructed 1936

Depth drilled 40 Depth cased 25

CASING RECORD:
6 inch

FINISH:

AQUIFERS:

WATER LEVEL:

13 feet

PUMPING EQUIPMENT: Type Centrifugal H.P. 7 1/2
Capacity 300 G.P.M.

WELL TESTS:

Drawdown ft. after hours G.P.M.

Drawdown ft. after hours G.P.M.

USE OF WATER irrigation - 20 Ac. Temp. °F. 19

SOURCE OF INFORMATION GR-639

DRILLER or DIGGER --

ADDITIONAL DATA:

Log -- Water Level Measurements Chemical Analysis Aquifer Test

REMARKS: