

STATE ENGINEER
Salem, Oregon

LANE
7736

Well Record

GR- 1493


STATE WELL NO. 16/LW-10
COUNTY Lane
APPLICATION NO. GR- 1548

OWNER: Herman Kunkel
MAILING ADDRESS: 765 River Rd.

LOCATION OF WELL: Owner's No. #1
CITY AND STATE: Junction City, Oregon

NE 1/4 NW 1/4 Sec. 4 T. 16 S., R. 4 W., W.M.

Bearing and distance from section or subdivision
corner 15 1/2 ch. S. & 28 1/2 ch. E. from NW cor. Sec. 4

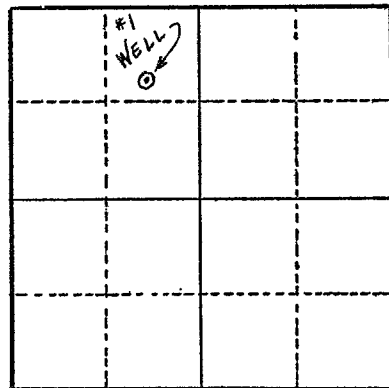

Section 4

Altitude at well

TYPE OF WELL: Driven Date Constructed 1948

Depth drilled 28' Depth cased 28'

CASING RECORD:
5"

FINISH:
Perforated from 5 to 7 ft.

AQUIFERS:

WATER LEVEL:
15'

PUMPING EQUIPMENT: Type Pacific 4" H.P. 15
Capacity 400 G.P.M.

WELL TESTS:
Drawdown ft. after hours G.P.M.
Drawdown ft. after hours G.P.M.

USE OF WATER Irrigation Temp. °F., 19

SOURCE OF INFORMATION GR Record

DRILLER or DIGGER

ADDITIONAL DATA:
Log N.A. Water Level Measurements Chemical Analysis Aquifer Test

REMARKS:
Irrigation of 50 acres.