

STATE ENGINEER
Salem, Oregon


LANE
7737 Well Record

STATE WELL NO. 16/LW-4F
COUNTY Lane
APPLICATION NO. GR-870

OWNER: L. H. Quinlan
MAILING ADDRESS: 1030 River Road

LOCATION OF WELL: Owner's No. _____
CITY AND STATE: Junction City

SE 1/4 NW 1/4 Sec. 4 T. 16 N S, R. 4 W, W.M.
Bearing and distance from section or subdivision
corner 8' N. & 22.5' W. from center of Sec. 4

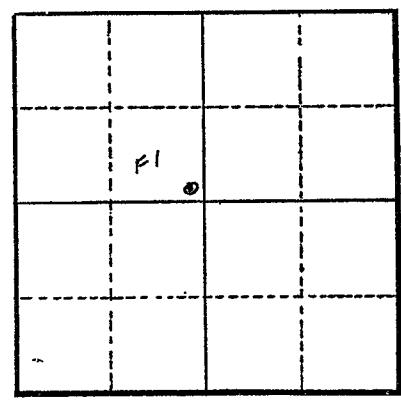

Altitude at well 335

TYPE OF WELL: driven Date Constructed Aug. '53

Depth drilled 29 Depth cased 29

Section 4

CASING RECORD:

5" dig 0' - 29'

FINISH:

Perforated Last 4 1/2' (24 1/2' - 29')

AQUIFERS:

WATER LEVEL:

15'

PUMPING EQUIPMENT: Type Cornell H.P. 15 G.E. Elec
Capacity 320 G.P.M.

WELL TESTS:
Drawdown 5 ft. after --- hours 320 G.P.M.
Drawdown _____ ft. after _____ hours _____ G.P.M.

USE OF WATER irrigation Temp. °F. _____, 19

SOURCE OF INFORMATION owner

DRILLER or DIGGER D. D. Dickenson, 1280 River Road - Junction City

ADDITIONAL DATA:
Log NA Water Level Measurements _____ Chemical Analysis _____ Aquifer Test _____

REMARKS: