

STATE ENGINEER  
Salem, Oregon

Well Record

LANE  
7740

STATE WELL NO. 16/4W-4L  
COUNTY Lane  
APPLICATION NO. GR-3734

65473

OWNER: Carey L. Strome


MAILING ADDRESS: P.O. Box 548

LOCATION OF WELL: Owner's No.

CITY AND STATE: Junction City, Oregon

NE 1/4 SW 1/4 Sec. 4 T. 16 S., R. 4 W., W.M.

Bearing and distance from section or subdivision corner 3100 ft. S. 27° 50' E. of NW Cor. Sec. 4

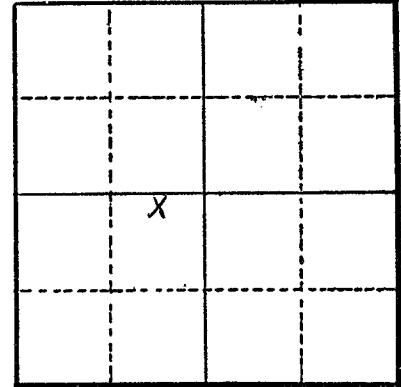

Section 4

Altitude at well

TYPE OF WELL: Driven Date Constructed 10/15/52

Depth drilled 30 feet Depth cased 30 feet

CASING RECORD:

6" i.d. steel casing set to 30 feet

FINISH:

1/2" slots 2' long from 25 to 30 feet

AQUIFERS:

WATER LEVEL:

9 feet below surface

PUMPING EQUIPMENT: Type Cornell 4" x 5" shallow well H.P. 25  
Capacity 500 G.P.M.

WELL TESTS:

Drawdown 3 ft. after 750 hours G.P.M.  
Drawdown ft. after hours G.P.M.

USE OF WATER Irrigation Temp. °F., 19

SOURCE OF INFORMATION Well Registration Statement

DRILLER or DIGGER Everett Scott

ADDITIONAL DATA:

Log Water Level Measurements Chemical Analysis Aquifer Test

REMARKS: