

STATE ENGINEER  
Salem, Oregon

**LANE**  
**7741**

# Well Record

STATE WELL NO. 16/4W - 4L  
COUNTY LANE  
APPLICATION NO. GR-2026

OWNER: Harold Wickwire


MAILING ADDRESS: 350 Wickwire Lane

LOCATION OF WELL: Owner's No. \_\_\_\_\_

CITY AND STATE: Junction City, Oregon

$E\frac{1}{2}$  NE  $\frac{1}{4}$  SW  $\frac{1}{4}$  Sec. 4 T. 16 S., R. 4 W., W.M.

Bearing and distance from section or subdivision corner 2952' N. and 2313' W.

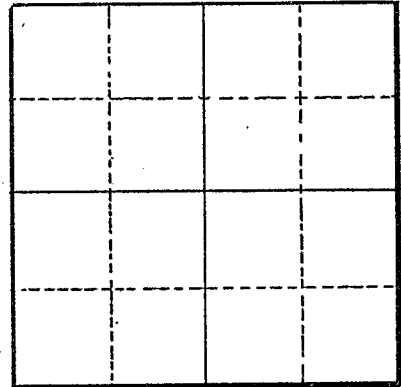

Section \_\_\_\_\_

Altitude at well \_\_\_\_\_

TYPE OF WELL: Driven Date Constructed 1947

Depth drilled 25 Depth cased \_\_\_\_\_

### CASING RECORD:

### FINISH:

Perforations from 23' to 25'

### AQUIFERS:

Sand

### WATER LEVEL:

20-feet

PUMPING EQUIPMENT: Type Allis Chalmers Low Pressure H.P. 7½  
Capacity 160 G.P.M.

### WELL TESTS:

Drawdown None ft. after \_\_\_\_\_ hours Pumping 150 G.P.M.  
Drawdown \_\_\_\_\_ ft. after \_\_\_\_\_ hours \_\_\_\_\_ G.P.M.

USE OF WATER Irrigation Temp. \_\_\_\_\_ °F., 19 \_\_\_\_\_

SOURCE OF INFORMATION GR-1952

DRILLER or DIGGER \_\_\_\_\_

### ADDITIONAL DATA:

Log  Water Level Measurements \_\_\_\_\_ Chemical Analysis \_\_\_\_\_ Aquifer Test \_\_\_\_\_

### REMARKS:

Sand loam 20' 20'  
Sand & Gravel 5' 25'