

STATE ENGINEER
Salem, Oregon

LANE Well Record
7742

STATE WELL NO. 16/4W-47 c.b
COUNTY Lane
APPLICATION NO. GR-3732

G 5450

OWNER: Carey L. Stroma


MAILING ADDRESS: P.O. Box 548

LOCATION OF WELL: Owner's No. _____

CITY AND STATE: Junction City, Oregon

Well #1
NW 1/4 SW 1/4 Sec. 4 T. 16 S. R. 4 W., W.M.

Bearing and distance from section or subdivision
corner 3015 ft. S. 03° 00' E. of NW Cor. Sec. 4

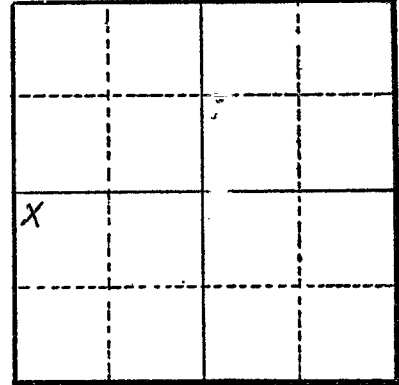

Section 4

Altitude at well _____

TYPE OF WELL: Driven Date Constructed 9/15/52

Depth drilled 30 feet Depth cased 30 feet

CASING RECORD:

6 i.d. inch steel casing set to 30 feet

FINISH:

1/2" slots - 2' long from 25 to 30 feet

AQUIFERS:

WATER LEVEL:

9 feet below surface

PUMPING EQUIPMENT: Type Cornell 4" x 5" shallow well H.P. 25
Capacity 500 G.P.M.

WELL TESTS:

Drawdown 3 ft. after _____ hours 750 G.P.M.
Drawdown _____ ft. after _____ hours _____ G.P.M.

USE OF WATER Irrigation Temp. _____ °F., 19 _____

SOURCE OF INFORMATION Well Registration Statement

DRILLER or DIGGER Everett Scott

ADDITIONAL DATA:

Log _____ Water Level Measurements _____ Chemical Analysis _____ Aquifer Test _____

REMARKS:

3405