

STATE ENGINEER
Salem, Oregon

LANE
7743

Well Record


STATE WELL NO. 16/4W-4M cb
COUNTY Lane
APPLICATION NO. GR-3733
G 5450

OWNER: Carey L. Stroma MAILING ADDRESS: P.O. Box 548

LOCATION OF WELL: Owner's No. _____ CITY AND STATE: Junction City, Oregon

Well # 2
NW 1/4 SW 1/4 Sec. 4 T. 16 N. S., R. 4 E. W., W.M.

Bearing and distance from section or subdivision corner 3012 ft. S. 02° 15' E. of NW Cor. Sec. 4

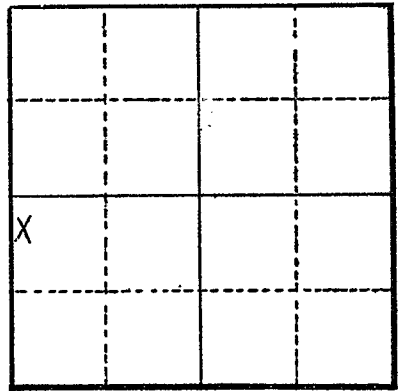

Altitude at well _____

TYPE OF WELL: Driven Date Constructed Sept., 1952

Depth drilled 30 feet Depth cased 30 feet

Section 4

CASING RECORD:

4" i.d. steel casing set to 30 feet

FINISH:

Slotted perforations from 25 to 30 feet

AQUIFERS:

WATER LEVEL:

9 feet below surface

PUMPING EQUIPMENT: Type Jacuzzi 2" x 3" shallow well H.P. 5
Capacity 125 G.P.M.

WELL TESTS:

Drawdown 3 ft. after _____ hours 150 G.P.M.
Drawdown _____ ft. after _____ hours _____ G.P.M.

USE OF WATER Irrigation Temp. _____ °F., 19 _____

SOURCE OF INFORMATION Well Registration Statement

DRILLER or DIGGER Everett Scott

ADDITIONAL DATA:

Log _____ Water Level Measurements _____ Chemical Analysis _____ Aquifer Test _____

REMARKS:

3406