

STATE ENGINEER
Salem, Oregon

LANE
7744

Well Record

STATE WELL NO. 16/4W-4Q
COUNTY LANE
APPLICATION NO. GR-2837

OWNER: Mrs. Nellie Koon

MAILING ADDRESS:

2020 River Road


LOCATION OF WELL: Owner's No.

CITY AND STATE:

Junction City, Oregon

SW 1/4 SE 1/4 Sec. 4 T. 16 N. S., R. 4 E. W.M.

Bearing and distance from section or subdivision corner 1860' S. 34° 30' E.

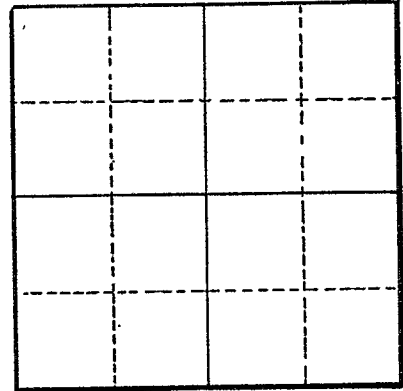

Section

Altitude at well

TYPE OF WELL: driven Date Constructed 1935

Depth drilled 24 Depth cased 24

CASING RECORD:

4-inch

FINISH:

AQUIFERS:

Loam, sand and gravel

WATER LEVEL:

12-feet

PUMPING EQUIPMENT: Type Centrifugal H.P. 40
Capacity 500 G.P.M.

WELL TESTS:

Drawdown 18 ft. after hours Pumping 500 G.P.M.
Drawdown ft. after hours G.P.M.

USE OF WATER irrigation Temp. °F. 19

SOURCE OF INFORMATION GR-2673

DRILLER or DIGGER

ADDITIONAL DATA:

Log X Water Level Measurements Chemical Analysis Aquifer Test

REMARKS:

Sandy loam 6 18
Sand and gravel 18 0