

STATE ENGINEER  
Salem, Oregon

LANE  
7145

# Well Record


STATE WELL NO. 16/LW-4R  
COUNTY Lane  
APPLICATION NO. GR-2158

OWNER: H. O. Paeschke  
MAILING ADDRESS: \_\_\_\_\_

LOCATION OF WELL: Owner's No. 4  
CITY AND STATE: Junction City, Oregon

SE 1/4 SE 1/4 Sec. 4 T. 16 S. R. 4 W., W.M.

Bearing and distance from section or subdivision corner 135 feet N. and 130 feet W.

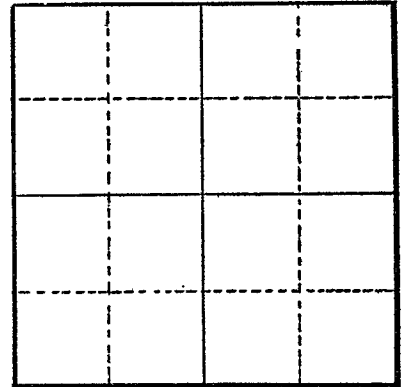

Altitude at well \_\_\_\_\_

TYPE OF WELL: Driven Date Constructed 1953

Depth drilled 23 feet Depth cased 23 feet

Section \_\_\_\_\_

### CASING RECORD:

4-inch

### FINISH:

Standard perforations from 19 to 23

### AQUIFERS:

Loam top soil and sand and gravel

### WATER LEVEL:

11 feet

PUMPING EQUIPMENT: Type Misc. Portable Pumps H.P. \_\_\_\_\_  
Capacity 230 G.P.M.

### WELL TESTS:

Drawdown 3.5 ft. after \_\_\_\_\_ hours Pumping 230 G.P.M.  
Drawdown \_\_\_\_\_ ft. after \_\_\_\_\_ hours \_\_\_\_\_ G.P.M.

USE OF WATER Irrigation Temp. \_\_\_\_\_ °F. \_\_\_\_\_, 19

SOURCE OF INFORMATION GR-2884

DRILLER or DIGGER \_\_\_\_\_

### ADDITIONAL DATA:

Log  Water Level Measurements \_\_\_\_\_ Chemical Analysis \_\_\_\_\_ Aquifer Test \_\_\_\_\_

### REMARKS:

Loam top soil	4	19
Sand and gravel	8	11
Sand and coarse gravel	11	0