

STATE ENGINEER  
Salem, Oregon

LANE  
7768

# Well Record


STATE WELL NO. 16/4W-5A  
COUNTY LANE  
APPLICATION NO. GR-2594

OWNER: O. N. Petersen  
MAILING ADDRESS: 50 Strome Lane

LOCATION OF WELL: Owner's No.  
CITY AND STATE: Junction City, Oregon

NE 1/4 NE 1/4 Sec. 5 T. 16 S, R. 4 W., W.M.

Bearing and distance from section or subdivision corner 860' S and 690' W.

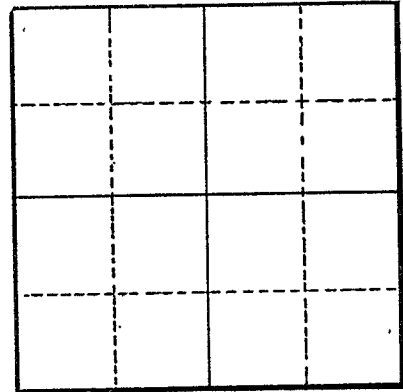

Section

Altitude at well

TYPE OF WELL: Driven Date Constructed 1925

Depth drilled 28 Depth cased 28

### CASING RECORD:

(2) - 4-inch

### FINISH:

Standard perforations from 24 to 28

### AQUIFERS:

Loam, sand and gravel

### WATER LEVEL:

10-feet

PUMPING EQUIPMENT: Type Cornell Centrifugal H.P. 10  
Capacity 200 G.P.M.

### WELL TESTS:

Drawdown 15 ft. after hours Pumping 250 G.P.M.  
Drawdown ft. after hours G.P.M.

USE OF WATER Irrigation Temp. °F., 19

SOURCE OF INFORMATION GR-2461

DRILLER or DIGGER

### ADDITIONAL DATA:

Log  Water Level Measurements Chemical Analysis Aquifer Test

### REMARKS:

Loam 4 24  
Sand & gravel 24 0