

STATE ENGINEER  
Salem, Oregon

LANE  
7769

# Well Record

STATE WELL NO. 16/4W-5A  
COUNTY Lane  
APPLICATION NO.


OWNER: Metha Rogers

MAILING ADDRESS: 198 Strome Lane

LOCATION OF WELL: Owner's No.

CITY AND STATE: Junction City, Oregon

NE 1/4 NE 1/4 Sec. 5 T. 16 S., R. 4 W., W.M.  
Bearing and distance from section or subdivision  
corner 970' S. & 460' W. from NE cor. of  
section 5.

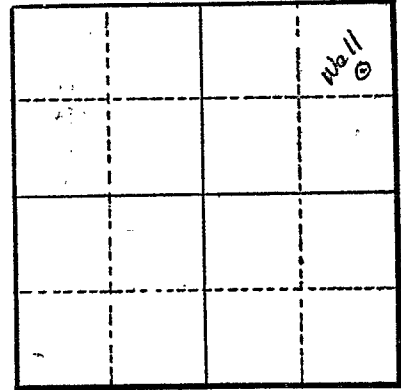

Section 5

Altitude at well 300 ft.

TYPE OF WELL: Driven Date Constructed 1944

Depth drilled 30 ft. Depth cased 30 ft.

### CASING RECORD:

2 inch

### FINISH:

2 inch regular perforated pipe from 27 to 30 ft.

### AQUIFERS:

### WATER LEVEL:

20 ft.

PUMPING EQUIPMENT: Type Goulds (Pressure system) H.P. 1

Capacity 100 G.P.M.

### WELL TESTS:

Drawdown 2 ft. after 100 hours G.P.M.

Drawdown ft. after hours G.P.M.

USE OF WATER Dom. & Irrigation Temp. °F., 19

SOURCE OF INFORMATION Belated registration statement

DRILLER or DIGGER

### ADDITIONAL DATA:

Log Water Level Measurements Chemical Analysis Aquifer Test

### REMARKS:

Log: Silt loam	0 to 6 ft.
Fine sand	6 to 10 ft.
Sand & gravel	10 to 30 ft.

Irrigation of 6 acres.