

STATE ENGINEER
Salem, Oregon

LANE
7775

Well Record

STATE WELL NO. 16/LW-5M
COUNTY Lane
APPLICATION NO. GR-3117

OWNER: George H. Bailey


MAILING ADDRESS: 451 Prairie Road

LOCATION OF WELL: Owner's No.

CITY AND STATE: Junction City, Oregon

NW 1/4 SW 1/4 Sec. 5 T. 16 S., R. 4 W., W.M.

Bearing and distance from section or subdivision corner 2680' N. and 460' E.

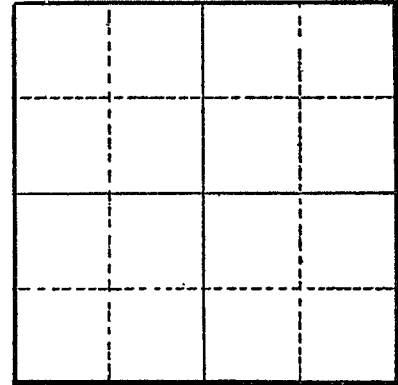

Section

Altitude at well

TYPE OF WELL: Driven Date Constructed 1948

Depth drilled 27' Depth cased

CASING RECORD:

FINISH:

5' (1/4" to 1/2" long perforations) from 22 to 27'

AQUIFERS:

soil
gravel

WATER LEVEL:

10'

PUMPING EQUIPMENT: Type Fairbanks Morse H.P. 10-20
Capacity 300 G.P.M.

WELL TESTS:

Drawdown 9 ft. after hours pumping 450 G.P.M.
Drawdown ft. after hours G.P.M.

USE OF WATER Irrigation Temp. °F., 19

SOURCE OF INFORMATION GR-2949

DRILLER or DIGGER owner

ADDITIONAL DATA:

Log Water Level Measurements Chemical Analysis Aquifer Test

REMARKS:

top soil 22'
gravel 5'