

STATE ENGINEER  
Salem, Oregon

LANE  
7798

# Well Record


STATE WELL NO. 16/LW-6A  
COUNTY LANE  
APPLICATION NO. GR-2928

OWNER: Ray O. Schulz  
MAILING ADDRESS: 1005 W. 1st

LOCATION OF WELL: Owner's No.  
CITY AND STATE: Junction City, Oregon

NE 1/4 NE 1/4 Sec. 6 T. 16<sup>N.</sup> S., R. 4<sup>E.</sup> W., W.M.

Bearing and distance from section or subdivision corner 250' S. and 720' W.

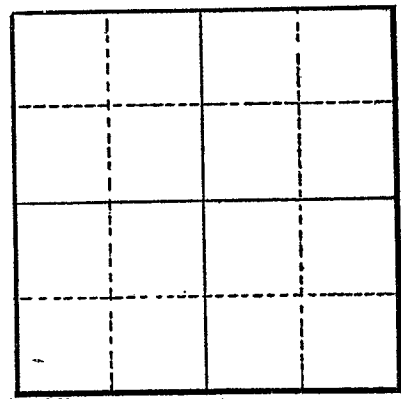

Section .....

Altitude at well .....

TYPE OF WELL: driven Date Constructed .....

Depth drilled 29 Depth cased .....

### CASING RECORD:

### FINISH:

### AQUIFERS:

WATER LEVEL: 19-feet

PUMPING EQUIPMENT: Type Deming Pump H.P. 3  
Capacity 60 G.P.M.

WELL TESTS:  
Drawdown ..... ft. after ..... hours ..... G.P.M.  
Drawdown ..... ft. after ..... hours ..... G.P.M.

USE OF WATER Irrigation Temp. °F. ...., 19

SOURCE OF INFORMATION GR-2755

DRILLER or DIGGER .....

ADDITIONAL DATA:  
Log ..... Water Level Measurements ..... Chemical Analysis ..... Aquifer Test .....

### REMARKS: