

STATE ENGINEER
Salem, Oregon

LANE
7799

Well Record


STATE WELL NO. 16/LW-6A
COUNTY Lane
APPLICATION NO. GR-3401

OWNER: Herbert C. Bower
MAILING ADDRESS: 100 Prairie Road

LOCATION OF WELL: Owner's No. _____
CITY AND STATE: Junction City, Oregon

NE 1/4 NE 1/4 Sec. 6 T. 16 N. S., R. 4 W., W.M.

Bearing and distance from section or subdivision
corner 350' S. and 200' W.

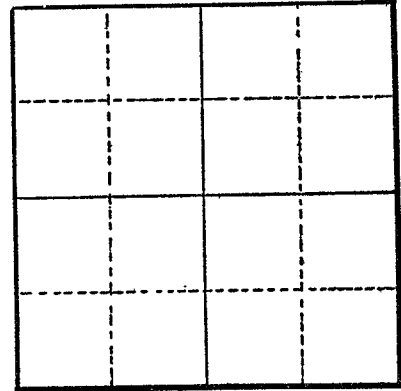

Section

Altitude at well

TYPE OF WELL: driven Date Constructed 1953

Depth drilled 21' Depth cased 21'

CASING RECORD:
3"

FINISH:

3 slots per foot from 18 to 21

AQUIFERS:

silt loam, sand and gravel

WATER LEVEL:

PUMPING EQUIPMENT: Type Pacific H.P. 3
Capacity 80 G.P.M.

WELL TESTS:

Drawdown ft. after hours G.P.M.
Drawdown ft. after hours G.P.M.

USE OF WATER Irrigation Temp. °F., 19

SOURCE OF INFORMATION GR-3148

DRILLER or DIGGER

ADDITIONAL DATA:

Log Water Level Measurements Chemical Analysis Aquifer Test

REMARKS:

silt loam	2	2
loam	4	6
sand and gravel	15	21