

STATE ENGINEER  
Salem, Oregon

LANE  
7802

# Well Record

GR- 1159

STATE WELL NO. 16/4W-6G(1)  
COUNTY Lane  
APPLICATION NO. GR- 1198


OWNER: Chris L. Wilde  
MAILING ADDRESS: Rt. 1

LOCATION OF WELL: Owner's No. CITY AND STATE: Junction City, Oregon

SW 1/4 NE 1/4 Sec. 6 T. 16 S. R. 4 W. W.M.

Bearing and distance from section or subdivision

corner 2400' S. & 300' E. of N 1/4 cor. Sec. 6.

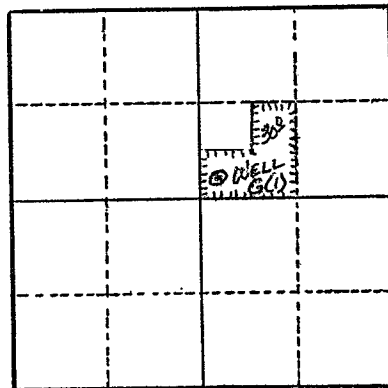

Section 6

Altitude at well 325 ft.

TYPE OF WELL: Dug Date Constructed 1949

Depth drilled 25 ft. Depth cased Sump

## CASING RECORD:

Sump - 20' x 60' x 25'

## FINISH:

## AQUIFERS:

## WATER LEVEL:

12 ft.

PUMPING EQUIPMENT: Type F. M. 2 in. Cent. H.P. 18

Capacity 300 G.P.M.

## WELL TESTS:

Drawdown ft. after hours G.P.M.

Drawdown ft. after hours G.P.M.

USE OF WATER Irrigation Temp. °F. 19

SOURCE OF INFORMATION G. R. Record

DRILLER or DIGGER Oldham

## ADDITIONAL DATA:

Log Water Level Measurements Chemical Analysis Aquifer Test

## REMARKS:

Log: Soil 0 to 8 ft.  
Cement  
gravel 8 to 25 ft.

Irrigation of 30 acres.