

STATE ENGINEER
Salem, Oregon

LANE
7817

Well Record


STATE WELL NO. 16/4W-7F
COUNTY Lane
APPLICATION NO. GR-4044

OWNER: James B. Pitney
MAILING ADDRESS: Star Route
CITY AND STATE: Junction City, Oregon

LOCATION OF WELL: Owner's No.
SE 1/4 NW 1/4 Sec. 7 T. 16 S. R. 4 W., W.M.

Bearing and distance from section or subdivision

corner 41 ch. E. & 31 1/2 ch. S. from NW Cor. Sec. 7

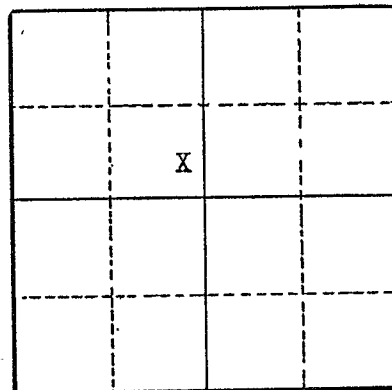

Section 7

Altitude at well

TYPE OF WELL: Driven Date Constructed 3/54

Depth drilled 28 ft. Depth cased 28 ft.

CASING RECORD:

3 inch well casing set to 28 feet

FINISH:

Slit bottom 36" from 26 to 28 feet

AQUIFERS:

WATER LEVEL:

8 feet below surface

PUMPING EQUIPMENT: Type Cornell centrifugal H.P. 3
Capacity 70 G.P.M.

WELL TESTS:

Drawdown ft. after hours G.P.M.
Drawdown ft. after hours G.P.M.

USE OF WATER Irrigation Temp. °F. 19

SOURCE OF INFORMATION Well Registration Statement Cert. # GR-3645

DRILLER or DIGGER

ADDITIONAL DATA:

Log Water Level Measurements Chemical Analysis Aquifer Test

REMARKS: