

STATE ENGINEER  
Salem, Oregon

LANE  
7808

# Well Record

STATE WELL NO. 16/4W-7F  
COUNTY Lane  
APPLICATION NO. GR-4045

OWNER: James B. Pitney

MAILING

ADDRESS: Star Route

LOCATION OF WELL: Owner's No.


CITY AND

STATE: Junction City, Oregon

SE  $\frac{1}{4}$  NW  $\frac{1}{4}$  Sec. 7 T. 16 S. R. 4 W., W.M.

Bearing and distance from section or subdivision

corner  $31\frac{1}{2}$  ch. S. 36 ch. E. from NW Cor. Sec. 7

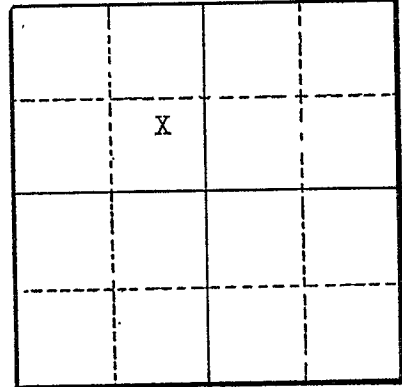

Section 7

Altitude at well

TYPE OF WELL: Driven Date Constructed 1954

Depth drilled 32 ft. Depth cased 32 ft.

## CASING RECORD:

3 inch well casing set to 32 feet

## FINISH:

Slits bottom 36" from 29 to 32 feet

## AQUIFERS:

## WATER LEVEL:

8 feet below surface

PUMPING EQUIPMENT: Type Jacuzzi centrifugal H.P. 3  
Capacity 80 G.P.M.

## WELL TESTS:

Drawdown ft. after hours G.P.M.  
Drawdown ft. after hours G.P.M.

USE OF WATER Irrigation Temp. °F., 19  
SOURCE OF INFORMATION Well Registration Statement Cert. # GR-3646

DRILLER or DIGGER

## ADDITIONAL DATA:

Log Water Level Measurements Chemical Analysis Aquifer Test

## REMARKS: