

STATE ENGINEER
Salem, Oregon

LANE
7819

Well Record

GR- 1345

STATE WELL NO. 16/4W-7H
COUNTY Lane
APPLICATION NO. GR- 1388

OWNER: C. W. Kokkeler

MAILING

ADDRESS: Rt. 1, Box 215

LOCATION OF WELL: Owner's No.


CITY AND

STATE: Eugene, Oregon

SE 1/4 NE 1/4 Sec. 7 T. 16 S., R. 4 W., W.M.

Bearing and distance from section or subdivision

corner 330' W. & 2075' S. from NE cor. Sec. 7

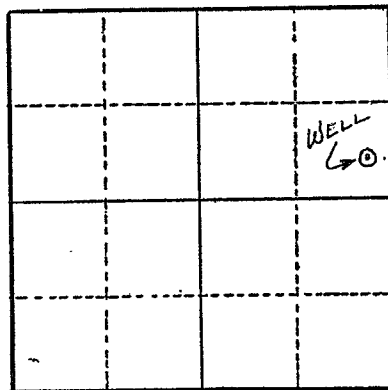

Section 7

Altitude at well

TYPE OF WELL: Drilled Date Constructed 1950

Depth drilled 53 ft. Depth cased 53 ft.

CASING RECORD:

4 inch

FINISH:

Perforated: 2 per ft. from 21 to 53 ft.

AQUIFERS:

WATER LEVEL:

10 ft.

PUMPING EQUIPMENT: Type 2 in. Cent. H.P. 5

Capacity 125 G.P.M.

WELL TESTS:

Drawdown ft. after hours G.P.M.

Drawdown ft. after hours G.P.M.

USE OF WATER Irrigation Temp. °F. 19

SOURCE OF INFORMATION G. R. Record

DRILLER or DIGGER Cook

ADDITIONAL DATA:

Log N.A. Water Level Measurements Chemical Analysis Aquifer Test

REMARKS:

Irrigation of 14 acres.