

STATE OF OREGON
WATER SUPPLY WELL REPORT
(as required by ORS 537.765 & OAR 690-205-0210)

LANE 78340

WELL I.D. LABEL# L

141274

START CARD #

1049883

11/18/2021

ORIGINAL LOG #

(1) LAND OWNER

Owner Well I.D.

First Name Last Name
Company USDA FOREST SERVICE / WILLAMETTE NATIONAL FOREST
Address 3106 PIERCE PARKWAY, STE D
City SPRINGFIELD State OR Zip 97477

(2) TYPE OF WORK

[X] New Well [] Deepening [] Conversion
[] Alteration (complete 2a & 10) [] Abandonment (complete 5a)

(2a) PRE-ALTERATION

Casing: Dia + From To Gauge Stl Plstc Wld Thrld
Material From To Amt sacks/lbs
Seal: [] [] [] [] [] [] [] []

(3) DRILL METHOD

[X] Rotary Air [] Rotary Mud [] Cable [] Auger [] Cable Mud
[] Reverse Rotary [] Other

(4) PROPOSED USE

[] Domestic [] Irrigation [] Community
[] Industrial/ Commercial [] Livestock [] Dewatering
[] Thermal [] Injection [X] Other WALDO LAKE CAMPGROUND

(5) BORE HOLE CONSTRUCTION

Special Standard [] (Attach copy)
Depth of Completed Well 193.00 ft.

Table with columns: Dia, From, To, Material, From, To, Amt, sacks/lbs. Rows include Bentonite Chips and Cement.

How was seal placed: Method [] A [] B [] C [] D [] E

[X] Other PRESSURE GROUT, TR

Backfill placed from ft. to ft. Material

Filter pack from ft. to ft. Material Size

Explosives used: [] Yes Type Amount

(5a) ABANDONMENT USING UNHYDRATED BENTONITE

Proposed Amount Actual Amount

(6) CASING/LINER

Table with columns: Casing, Liner, Dia, From, To, Gauge, Stl, Plstc, Wld, Thrld

Shoe [X] Inside [] Outside [] Other Location of shoe(s) 178

Temp casing [] Yes Dia From + To

(7) PERFORATIONS/SCREENS

Perforations Method OXY/ACE

Screens Type Material

Table with columns: Perf/ Screen, Casing/ Screen, Dia, From, To, Scrn/slot width, Slot length, # of slots, Tele/ pipe size

(8) WELL TESTS: Minimum testing time is 1 hour

[] Pump [] Bailer [X] Air [] Flowing Artesian

Table with columns: Yield gal/min, Drawdown, Drill stem/Pump depth, Duration (hr)

Temperature 51 °F Lab analysis [] Yes By

Water quality concerns? [] Yes (describe below) TDS amount 133 ppm

Table with columns: From, To, Description, Amount, Units

(9) LOCATION OF WELL (legal description)

County LANE Twp 22.00 S N/S Range 6.00 E E/W WM
Sec 5 NW 1/4 of the NW 1/4 Tax Lot WNF
Tax Map Number Lot
Lat " or 43.70101929 DMS or DD
Long " or -122.04226647 DMS or DD
[] Street address of well [X] Nearest address

SHADOW BAY CAMPGROUND WELL / WALDO LAKE

(10) STATIC WATER LEVEL

Table with columns: Date, SWL(psi), SWL(ft)

Flowing Artesian? [] Dry Hole? []

WATER BEARING ZONES

Depth water was first found 132.00

Table with columns: SWL Date, From, To, Est Flow, SWL(psi), SWL(ft)

(11) WELL LOG

Ground Elevation 5500.00

Table with columns: Material, From, To. Lists various soil types like TOPSOIL W/BASALT BOULDERS GREY.

Date Started 9/30/2021 Completed 10/18/2021

(unbonded) Water Well Constructor Certification

I certify that the work I performed on the construction, deepening, alteration, or abandonment of this well is in compliance with Oregon water supply well construction standards.

License Number Date

Signed

(bonded) Water Well Constructor Certification

I accept responsibility for the construction, deepening, alteration, or abandonment work performed on this well during the construction dates reported above.

License Number 1965 Date 11/18/2021

Signed NEIL LEE (E-filed)


Contact Info (optional) leedrilling2014@gmail.com Neil W.Lee 541-790-1602

WATER SUPPLY WELL REPORT - Map with location identified must be attached and shall include an approximate scale and north arrow

LANE 78340

11/18/2021

Map of Hole

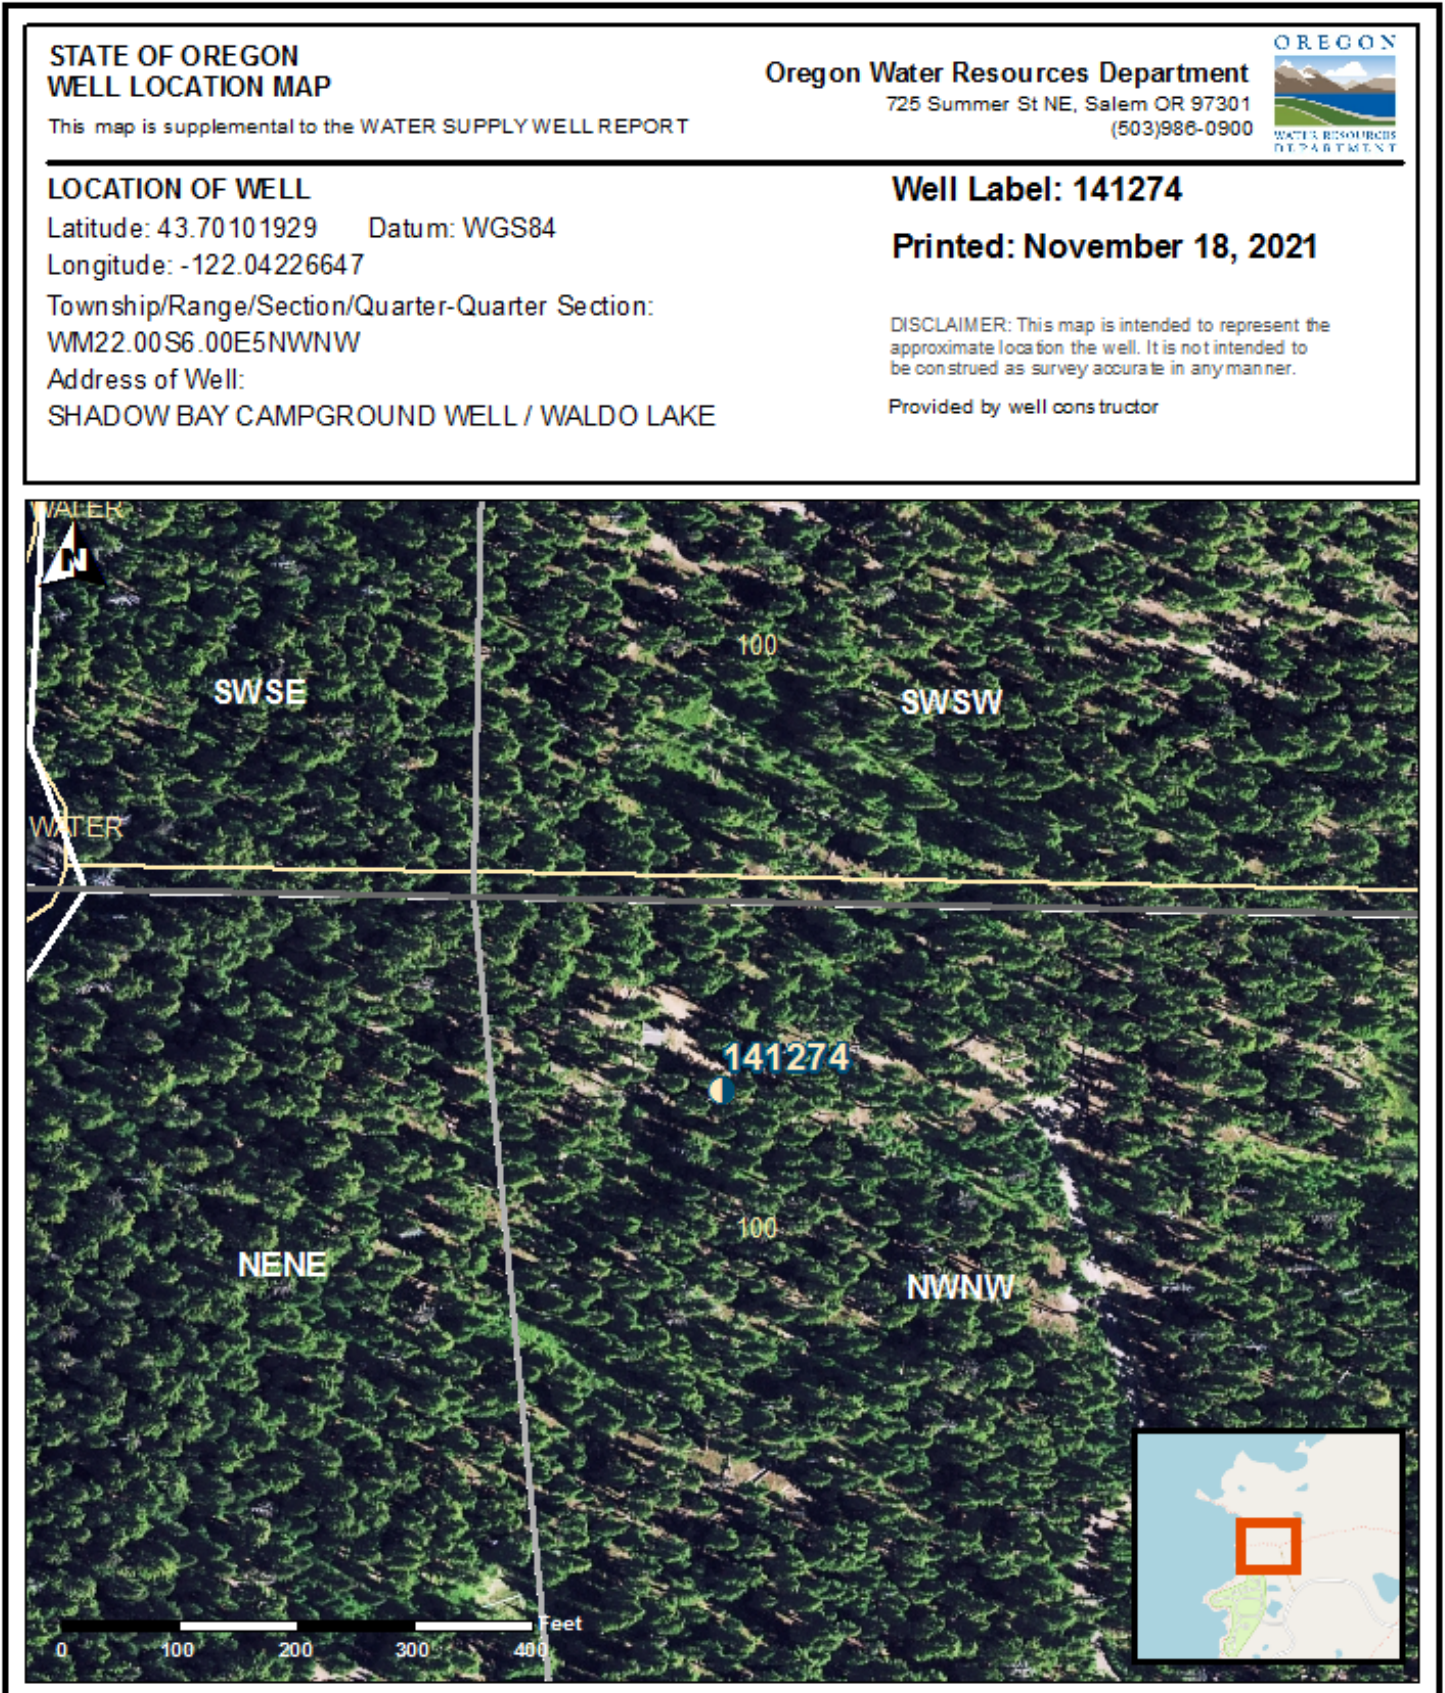

STATE OF OREGON
WELL LOCATION MAP

This map is supplemental to the WATER SUPPLY WELL REPORT

Oregon Water Resources Department
725 Summer St NE, Salem OR 97301
(503)986-0900



LOCATION OF WELL

Latitude: 43.70101929 Datum: WGS84

Longitude: -122.04226647

Township/Range/Section/Quarter-Quarter Section:

WM22.00S6.00E5NWNW

Address of Well:

SHADOW BAY CAMPGROUND WELL / WALDO LAKE

Well Label: 141274

Printed: November 18, 2021

DISCLAIMER: This map is intended to represent the approximate location the well. It is not intended to be construed as survey accurate in any manner.

Provided by well constructor