

STATE ENGINEER
Salem, Oregon

LANE
1839 Well Record

STATE WELL NO. 16/4W-8J
COUNTY Lane
APPLICATION NO. GR-1163

OWNER: Frank Culver

MAILING
ADDRESS:

Route 2

LOCATION OF WELL: Owner's No.


CITY AND
STATE:

Junction City, Oregon

NE ¼ SE ¼ Sec. 8 T. 16 N. S., R. 4 E. W., W.M.

Bearing and distance from section or subdivision

corner

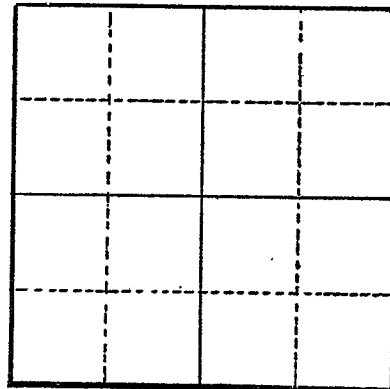

Section 8

Altitude at well

TYPE OF WELL: Drilled Date Constructed 1943

Depth drilled 12 Depth cased 12

CASING RECORD:

6-inch from 0 to 12 feet

FINISH:

Unknown

AQUIFERS:

WATER LEVEL:

6 feet

PUMPING EQUIPMENT: Type Carter 2" H.P. 4
Capacity 140 G.P.M.

WELL TESTS:

Drawdown ft. after hours G.P.M.

Drawdown ft. after hours G.P.M.

USE OF WATER Irrigation Temp. °F. 19

SOURCE OF INFORMATION GR-1163

DRILLER or DIGGER

ADDITIONAL DATA:

Log Water Level Measurements Chemical Analysis Aquifer Test

REMARKS: