

STATE ENGINEER
Salem, Oregon

LANE
7841

Well Record

STATE WELL NO. 16/4W-8N
COUNTY LANE
APPLICATION NO. GR-2596

OWNER: Carl L. Paeschke

MAILING

ADDRESS: Rt. 2, Junction City,

CITY AND


STATE: Oregon

LOCATION OF WELL: Owner's No.

SW 1/4 SW 1/4 Sec. 8 T. 16 N. R. 4 E. W.M.

Bearing and distance from section or subdivision

corner 860' N. & 1315' E.

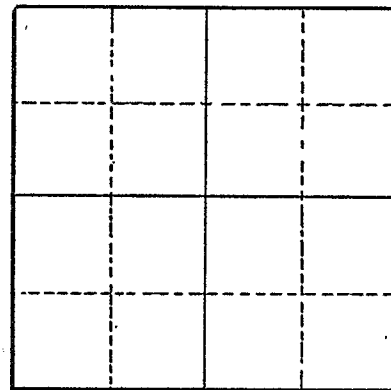

Section

Altitude at well

TYPE OF WELL: Drilled Date Constructed 1947

Depth drilled 40 Depth cased 40

CASING RECORD:

8-inch

FINISH:

AQUIFERS:

Clay, loam, sand and gravel

WATER LEVEL:

16-feet

PUMPING EQUIPMENT: Type Fairbanks Morse Centrifugal H.P. 15
Capacity 200 G.P.M.

WELL TESTS:

Drawdown 2 ft. after hours Pumping 200 G.P.M.

Drawdown ft. after hours G.P.M.

USE OF WATER Irrigation Temp. °F., 19

SOURCE OF INFORMATION GR-2463

DRILLER or DIGGER

ADDITIONAL DATA:

Log ☒ Water Level Measurements Chemical Analysis Aquifer Test

REMARKS:

Clay loam
Clay
Sand & gravel

3 37
2 35
35 0