

STATE ENGINEER
Salem, Oregon

LANE
7864

Well Record

STATE WELL NO. 16/LAN-9F
COUNTY LANE
APPLICATION NO. GR-2321

OWNER: Rupert B. Edwards


MAILING ADDRESS: 2410 River Road,

LOCATION OF WELL: Owner's No.

CITY AND STATE: Junction City, Oregon

SE 1/4 NW 1/4 Sec. 9 T. 16 N. 4 E. S., R. 4 W., W.M.

Bearing and distance from section or subdivision corner 1874' S. and 18' W.

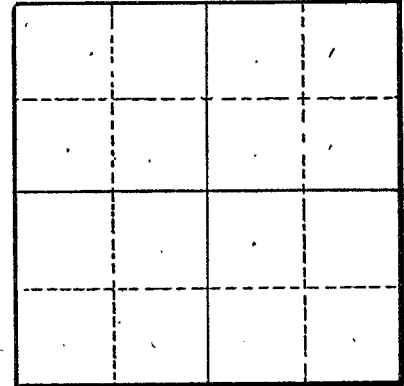

Section

Altitude at well

TYPE OF WELL: Driven Date Constructed 1955

Depth drilled 23 Depth cased 23

CASING RECORD:

2-inch

FINISH:

4 2 inch slits 3/8 wide at 90° 4 in. interval from 18 to 23

AQUIFERS:

Sand, loam and gravel

WATER LEVEL:

12-feet

PUMPING EQUIPMENT: Type Berkley 1 1/4 x 1 in H.P. 1/2
Capacity 35 G.P.M.

WELL TESTS:

Drawdown 6 ft. after hours Pumping 150 G.P.M.
Drawdown ft. after hours G.P.M.

USE OF WATER Peppermint Distillery, Water Temp. °F., 19.
SOURCE OF INFORMATION supply to fill spray tanks, etc. GR-2210

DRILLER or DIGGER

ADDITIONAL DATA:

Log X Water Level Measurements Chemical Analysis Aquifer Test

REMARKS:

Sandy loam & Gravel	0	10
Fine sand & gravel	10	20
Sand & Gravel	20	23