

LANE
7870

Well Record

STATE WELL NO. 16/4W-9G (2)
COUNTY Lane
APPLICATION NO. GR-742

OWNER: Rupert Edwards


MAILING ADDRESS: Rt. 2

LOCATION OF WELL: Owner's No. #1

CITY AND STATE: Jct. City, Oregon

SW 1/4 NE 1/4 Sec. 9 T. 16 S., R. 4 W., W.M.

Bearing and distance from section or subdivision corner 1954' S. & 277' E. from NW corner of NE 1/4 Section 9

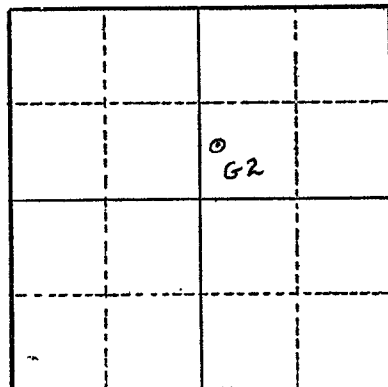

Altitude at well 335 ft.

TYPE OF WELL: Driven Date Constructed Aug. 20, 1934

Depth drilled 28' Depth cased 28'

Section 9

CASING RECORD:

4 in. from 0 to 28 ft.

FINISH:

AQUIFERS:

WATER LEVEL:

13.5 ft.

PUMPING EQUIPMENT: Type Gas - Pacific cent. 3 X 4 H.P. 30
Capacity 500 G.P.M.

WELL TESTS:
Drawdown 6 ft. after _____ hours 600 G.P.M.
Drawdown _____ ft. after _____ hours _____ G.P.M.

USE OF WATER irrigation Temp. _____ °F. _____, 19

SOURCE OF INFORMATION GR-742

DRILLER or DIGGER _____

ADDITIONAL DATA:

Log Water Level Measurements _____ Chemical Analysis _____ Aquifer Test _____

REMARKS:

