

STATE ENGINEER
Salem, Oregon

LANE
7891

Well Record

STATE WELL NO. 16/LW-9H (1)
COUNTY Lane
APPLICATION NO. GR-757

OWNER: Rupert Edwards


MAILING ADDRESS: Rt. 2,

LOCATION OF WELL: Owner's No. #3

CITY AND STATE: Junction City, Oregon

SE 1/4 NE 1/4 Sec. 9 T. 16 N S, R. 4 W, W.M.

Bearing and distance from section or subdivision
corner 3' N & 5' W of S.E. corner of SE 1/4 of NE 1/4
of section 9.

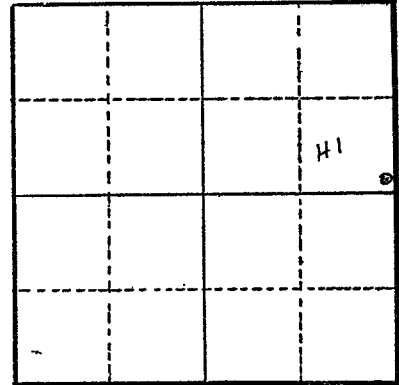

Altitude at well 330 feet Interpolated

TYPE OF WELL: Driven Date Constructed Oct. 15, 1946

Depth drilled 25 ft. Depth cased 25 ft.

Section 9

CASING RECORD:

Pipe pointed with bottom 4 ft. having 4 rows of slits 90° apart, 4 in. long by 5/16 in. wide

FINISH:

AQUIFERS:

WATER LEVEL:

10 ft.

PUMPING EQUIPMENT: Type Gas - Pacific cent. 4 X 3 in. H.P. 30

Capacity 500 G.P.M.

WELL TESTS:

Drawdown 2 ft. after 500 hours G.P.M.

Drawdown ft. after hours G.P.M.

USE OF WATER irrigation Temp. °F., 19

SOURCE OF INFORMATION GR-757

DRILLER or DIGGER

ADDITIONAL DATA:

Log Water Level Measurements Chemical Analysis Aquifer Test

REMARKS:

