

STATE ENGINEER
Salem, Oregon

LANE
7872

Well Record

STATE WELL NO. 16/4W-9J
COUNTY LANE
~~APPLICATION NO.~~ GR-2726

OWNER: Kenneth W. Dunn


MAILING ADDRESS: 4246 Riverroad

LOCATION OF WELL: Owner's No. #3

CITY AND STATE: Junction City, Oregon

NE 1/4 SE 1/4 Sec. 9 T. 16 S., R. 4 W., W.M.

Bearing and distance from section or subdivision corner 1370' N. and 850' W.

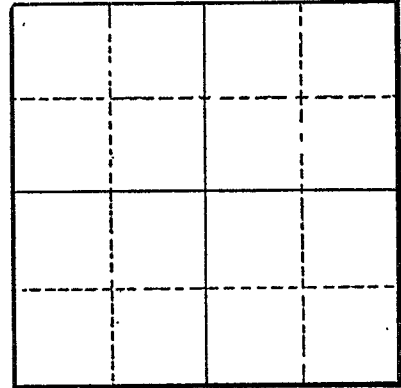

Section

Altitude at well

TYPE OF WELL: driven Date Constructed 1935

Depth drilled 26 Depth cased 26

CASING RECORD:

2-inch

FINISH:

Standard perforations from 22 to 26

AQUIFERS:

Loam, clay, sand and gravel

WATER LEVEL:

12-feet

PUMPING EQUIPMENT: Type Fairbanks Centrifugal H.P. 10
Capacity 120 G.P.M.

WELL TESTS:

Drawdown 2 ft. after hours Pumping 120 G.P.M.
Drawdown ft. after hours G.P.M.

USE OF WATER irrigation Temp. °F., 19

SOURCE OF INFORMATION GR-2579

DRILLER or DIGGER

ADDITIONAL DATA:

Log Water Level Measurements Chemical Analysis Aquifer Test

REMARKS:

Loam (Topsoil)	5	21
Clay Loam	3	13
Sand & gravel	13	0