

STATE ENGINEER
Salem, Oregon

LANE
7873

Well Record

STATE WELL NO. 16/4W-9J(1)
COUNTY Lane
APPLICATION NO. GR-796

OWNER: Leon E. Endres


MAILING ADDRESS: 2933 River Road

LOCATION OF WELL: Owner's No. #1

CITY AND STATE: Junction City, Oregon

NE 1/4 SE 1/4 Sec. 9 T. 16 S., R. 4 W., W.M.

Bearing and distance from section or subdivision corner

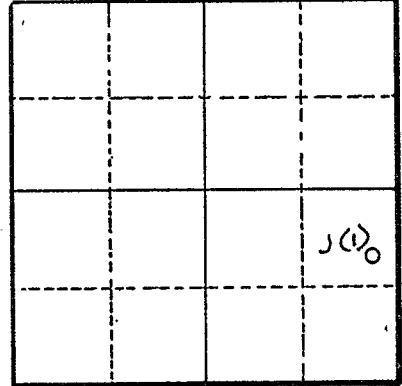

Altitude at well 359 feet

TYPE OF WELL: Driven Date Constructed May 15, '51

Depth drilled 21 ft. Depth cased 21 ft.

Section 9

CASING RECORD:

4 in. iron pipe pointed & slotted from 0 to 21 feet

FINISH:

Casing slotted from point up 30 in. with 3/16 in. slots 18 1/2 to 21 ft.

AQUIFERS:

WATER LEVEL:

7 feet

PUMPING EQUIPMENT: Type Gas - Pacific cent. 3x4 in. H.P. 30
Capacity 400 G.P.M.

WELL TESTS:

Drawdown ft. after hours G.P.M.
Drawdown ft. after hours G.P.M.

USE OF WATER Irrigation Temp. °F., 19

SOURCE OF INFORMATION GR-796

DRILLER or DIGGER

ADDITIONAL DATA:

Log Yes Water Level Measurements Chemical Analysis Aquifer Test

REMARKS:

