

STATE ENGINEER
Salem, Oregon

LANE
7874

Well Record

STATE WELL NO. 16/LW-9K (1)
COUNTY Lane
APPLICATION NO. GR-743

OWNER: Rupert Edwards


MAILING ADDRESS: Rt. 2

LOCATION OF WELL: Owner's No. #2

CITY AND STATE: Junction City, Oregon

NW 1/4 SE 1/4 Sec. 9 T. 16 N S. R. 4 W., W.M.

Bearing and distance from section or subdivision corner 1125' W. & 201.5' S. of SE corner of SE 1/4 of NE 1/4 section 9.

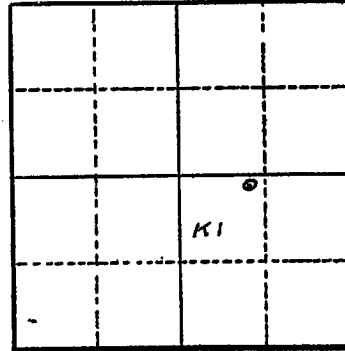

Section 9

Altitude at well 335 feet Interpolated

TYPE OF WELL: Driven Date Constructed July 2, 1945

Depth drilled 21' Depth cased 21'

CASING RECORD:

4 in. 0 to 21 feet

FINISH:

5/16 in. perforations, 4 in. long in 4 rows, 90° apart

AQUIFERS:

WATER LEVEL:

12 feet

PUMPING EQUIPMENT: Type Gas - Pacific cent. 4 X 3 in. H.P. 28
Capacity 500 G.P.M.

WELL TESTS:

Drawdown 2 ft. after _____ hours 500 G.P.M.

Drawdown _____ ft. after _____ hours _____ G.P.M.

USE OF WATER irrigation Temp. _____ °F. _____, 19____

SOURCE OF INFORMATION GR-743

DRILLER or DIGGER

ADDITIONAL DATA:

Log Yes Water Level Measurements _____ Chemical Analysis _____ Aquifer Test _____

REMARKS:

