

STATE ENGINEER  
Salem, Oregon

LANE  
1875

# Well Record

STATE WELL NO. 16/4W-90  
COUNTY Lane  
APPLICATION NO. GR-1305

GR- 1262

OWNER: Tom Harper


MAILING ADDRESS:

LOCATION OF WELL: Owner's No. #3

CITY AND STATE: Junction City, Oregon

SW 1/4 SE 1/4 Sec. 9 T. 16 S., R. 4 W., W.M.

Bearing and distance from section or subdivision corner S68°42'E. 1661' to SE cor. Sec. 9.

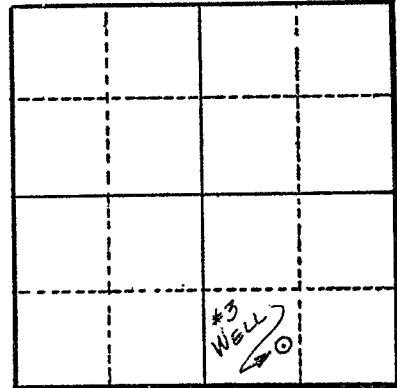

Section 9

Altitude at well 337 ft.

TYPE OF WELL: Drilled Date Constructed 1945

Depth drilled 24 ft. Depth cased 24 ft.

### CASING RECORD:

2- 4 inch

### FINISH:

### AQUIFERS:

### WATER LEVEL:

12 ft.

PUMPING EQUIPMENT: Type Cornell 2 1/2 x 3 1/2 in. Cent. H.P. 10  
Capacity 250 G.P.M.

### WELL TESTS:

Drawdown 5 ft. after hours 300 G.P.M.  
Drawdown ft. after hours G.P.M.

USE OF WATER Irrigation Temp. °F., 19

SOURCE OF INFORMATION G. R. Record

DRILLER or DIGGER Walt Nelson

### ADDITIONAL DATA:

Log N.A. Water Level Measurements Chemical Analysis Aquifer Test

### REMARKS:

Irrigation of 18 .8 acres.