

STATE ENGINEER
Salem, Oregon

LANE
7877


Well Record

STATE WELL NO. 16/LW-9R
COUNTY Lane
APPLICATION NO. CR-3654

OWNER: James & Audrey Hayes
MAILING ADDRESS: River Road

LOCATION OF WELL: Owner's No.
CITY AND STATE: Junction City, Oregon

SE 1/4 SE 1/4 Sec. 9 T. 16 N. S., R. 4 W., W.M.
Bearing and distance from section or subdivision
corner 870' W. & 900' N. from SE cor. Sec. 9

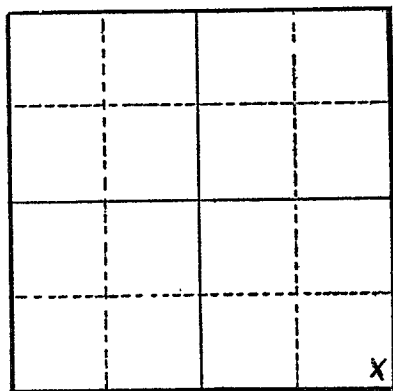

Section 9

Altitude at well

TYPE OF WELL: Driven Date Constructed 1947

Depth drilled 30 feet Depth cased

CASING RECORD:

FINISH:

Perforated 6 feet

AQUIFERS:

WATER LEVEL:

8 feet below surface

PUMPING EQUIPMENT: Type centrifugal H.P. 20
Capacity 1000 G.P.M.

WELL TESTS:

Drawdown ft. after hours 1000 G.P.M.
Drawdown ft. after hours G.P.M.

USE OF WATER Irrigation Temp. °F. 19

SOURCE OF INFORMATION Well Registration Statement

DRILLER or DIGGER

ADDITIONAL DATA:

Log Water Level Measurements Chemical Analysis Aquifer Test

REMARKS: