

STATE ENGINEER  
Salem, Oregon

**LINE**  
**7887**

# Well Record

STATE WELL NO. 16/LW-10F (1)  
COUNTY Lane  
APPLICATION NO. GR-266

OWNER: L. J. Zumwalt


MAILING ADDRESS: Rt. 2,

LOCATION OF WELL: Owner's No. #1

CITY AND STATE: Junction City, Oregon

SE 1/4 NW 1/4 Sec. 10 T. 16 N. S., R. 4 W., W.M.

Bearing and distance from section or subdivision corner N. 74° 02' W. 679.3 ft. and N. 0° 19' E. 491.4 ft. from the center of Section 10.

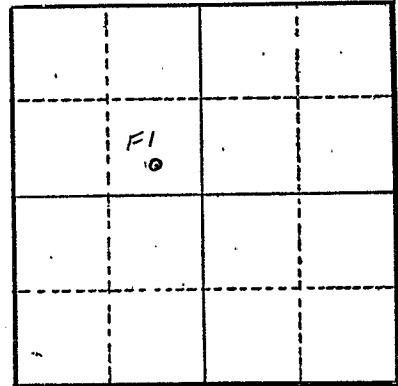

Section 10

Altitude at well 335 feet Interpolated

TYPE OF WELL: Drilled Date Constructed 1945

Depth drilled 20 Depth cased ?

CASING RECORD:

Unknown

FINISH:

Unknown

AQUIFERS:

Unknown

WATER LEVEL:

12 feet below land surface

PUMPING EQUIPMENT: Type 3 in. pump

H.P. --

Capacity 500 G.P.M.

WELL TESTS:

Drawdown 14 ft. after \_\_\_\_\_ hours pumping 500 G.P.M.

Drawdown \_\_\_\_\_ ft. after \_\_\_\_\_ hours \_\_\_\_\_ G.P.M.

USE OF WATER irrigation 10 acres Temp. \_\_\_\_\_ °F., 19

SOURCE OF INFORMATION Registration Statement Gr-266

DRILLER or DIGGER --

ADDITIONAL DATA:

Log No. Water Level Measurements \_\_\_\_\_ Chemical Analysis \_\_\_\_\_ Aquifer Test \_\_\_\_\_

REMARKS: