

STATE ENGINEER  
Salem, Oregon

**LANE**  
**7888**  
**Well Record**


STATE WELL NO. 16/LW-10F (2)  
COUNTY Lane  
APPLICATION NO. GR-266

OWNER: L. J. Zumwalt MAILING ADDRESS: Rt. 2,

LOCATION OF WELL: Owner's No. #2 CITY AND STATE: Junction City

SE  $\frac{1}{4}$  NW  $\frac{1}{4}$  Sec. 10 T. 16 S., R. 4 W., W.M.

Bearing and distance from section or subdivision corner N. 74° 02' W. 679.3 feet from center of section 10.

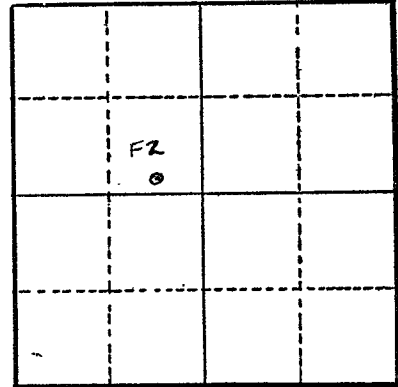

Section 10

Altitude at well 335 feet Interpolated

TYPE OF WELL: Drilled Date Constructed 1945

Depth drilled 20 Depth cased 20

CASING RECORD:

3 - inch casing set from 0-20 feet

FINISH:

none

AQUIFERS:

unknown

WATER LEVEL:

12 feet below land surface.

PUMPING EQUIPMENT: Type 3 inch pump H.P. Jeep Motor

Capacity 300 G.P.M.

WELL TESTS:

Drawdown 14 ft. after \_\_\_\_\_ hours pumping 300 G.P.M.

Drawdown \_\_\_\_\_ ft. after \_\_\_\_\_ hours \_\_\_\_\_ G.P.M.

USE OF WATER irrigation 10 acres Temp. \_\_\_\_\_ °F., 19 \_\_\_\_\_

SOURCE OF INFORMATION Registration Statement GR-266

DRILLER or DIGGER \_\_\_\_\_

ADDITIONAL DATA:

Log No. Water Level Measurements \_\_\_\_\_ Chemical Analysis \_\_\_\_\_ Aquifer Test \_\_\_\_\_

REMARKS: