

STATE ENGINEER  
Salem, Oregon

LANE  
7890

# Well Record

STATE WELL NO. 16/LW-10L (1)  
COUNTY Lane  
APPLICATION NO. GR-291

OWNER: Herbert C. Neave

MAILING ADDRESS: Rt. 2,


LOCATION OF WELL: Owner's No. #1

CITY AND STATE: Junction City, Oregon

NE 1/4 SW 1/4 Sec. 10 T. 16 S., R. 4 W., W.M.

Bearing and distance from section or subdivision

corner S. 47° 00' W. 652.46 feet from NE corner of SW 1/4 of section 10

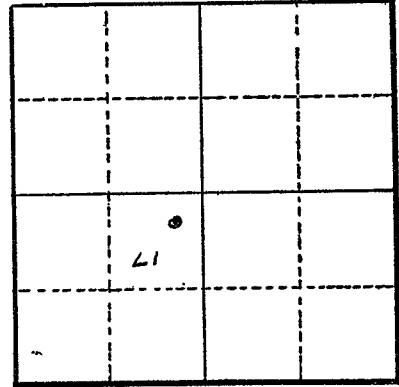

Section 10

Altitude at well 340 feet Interpolated

TYPE OF WELL: Driven Date Constructed July 1953

Depth drilled 25 Depth cased 25

### CASING RECORD:

4 - inch steel pipe driven from 0 to 25 feet.

### FINISH:

unknown

### AQUIFERS:

Gravel - ?

### WATER LEVEL:

20 feet below land surface. July 1953

PUMPING EQUIPMENT: Type 4" Gas pump H.P. 38 Gas  
Capacity 400 G.P.M.

WELL TESTS:  
Drawdown 25 ft. after \_\_\_\_\_ hours pumping 400 G.P.M.  
Drawdown \_\_\_\_\_ ft. after \_\_\_\_\_ hours \_\_\_\_\_ G.P.M.

USE OF WATER irrigation 9.7 acres Temp. \_\_\_\_\_ °F., 19

SOURCE OF INFORMATION Registration Statement GR-291

DRILLER or DIGGER ---

ADDITIONAL DATA:  
Log No. Water Level Measurements \_\_\_\_\_ Chemical Analysis \_\_\_\_\_ Aquifer Test \_\_\_\_\_

### REMARKS:

Gravel at 25 feet?