

STATE ENGINEER
Salem, Oregon

LANE
2891

Well Record

STATE WELL NO. 16/LW-10L (2)
COUNTY Lane
APPLICATION NO. GR-291


OWNER: Herbert C. Neare

MAILING ADDRESS: Rt. 2

LOCATION OF WELL: Owner's No. #2

CITY AND STATE: Junction City, Oregon

NE 1/4 SW 1/4 Sec. 10 T. 16 N S, R. 4 W., W.M.

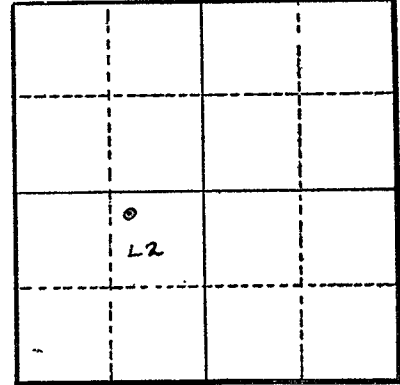

Bearing and distance from section or subdivision corner S. 79° 25' W. 1288.25 feet from N.E. corner of NE 1/4 of SW 1/4 of Section 10

Altitude at well 340 feet Interpolated

TYPE OF WELL: Driven Date Constructed July 1, 1953

Depth drilled 25 Depth cased 25

Section 10

CASING RECORD:

4 - inch steel pipe

FINISH:

unknown

AQUIFERS:

gravel

WATER LEVEL:

20 feet below land surface, July 1953

PUMPING EQUIPMENT: Type 4" pump ? Berkeley H.P. 38 Gas
Capacity 400 G.P.M.

WELL TESTS:
Drawdown 24 ft. after _____ hours pumping 400 G.P.M.
Drawdown _____ ft. after _____ hours _____ G.P.M.

USE OF WATER irrigation 19.9 acres Temp. _____ °F., 19____

SOURCE OF INFORMATION Reg. Statement GR-291

DRILLER or DIGGER _____

ADDITIONAL DATA:

Log No. Water Level Measurements _____ Chemical Analysis _____ Aquifer Test _____

REMARKS: