

STATE ENGINEER
Salem, Oregon

LANE
7892

Well Record


STATE WELL NO. 16/LW-10M (1)
COUNTY Lane
APPLICATION NO. GR-529

OWNER: Jacob Jager Jr. MAILING ADDRESS: _____

LOCATION OF WELL: Owner's No. _____ CITY AND STATE: Junction City, Oregon

NW 1/4 SW 1/4 Sec. 10 T. 16 S., R. 4 W., W.M.

Bearing and distance from section or subdivision corner about 116 feet E. & 294 ft. S. of W 1/4 cor. sec. 10

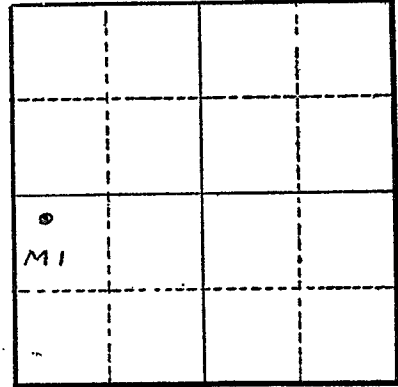

Section 10

Altitude at well 335 (Approx)

TYPE OF WELL: driven Date Constructed July 1948

Depth drilled 21 Depth cased 21

CASING RECORD:

4 inch

FINISH:

AQUIFERS:

WATER LEVEL:

7 ft. (Approx)

PUMPING EQUIPMENT: Type Pacific Centrifugal H.P. 20

Capacity 400 G.P.M.

WELL TESTS:

Drawdown _____ ft. after _____ hours _____ G.P.M.
Drawdown _____ ft. after _____ hours _____ G.P.M.

USE OF WATER irrigation - 10 Ac. Temp. _____ °F., 19

SOURCE OF INFORMATION GR-529

DRILLER or DIGGER Walter Nielson; Junction City, Ore.

ADDITIONAL DATA:

Log -- Water Level Measurements _____ Chemical Analysis _____ Aquifer Test _____

REMARKS: