

STATE ENGINEER
Salem, Oregon

LANE
7893

Well Record


STATE WELL NO. 16/4W-10N
COUNTY Lane
APPLICATION NO. Gr-2246

OWNER: Ida E. Hayes Sarah Hayes Estate MAILING ADDRESS: Route 2

LOCATION OF WELL: Owner's No. _____ CITY AND STATE: Junction City, Oregon

SW $\frac{1}{4}$ SW $\frac{1}{4}$ Sec. 10 T. 16 S., R. 4 W., W.M.

Bearing and distance from section or subdivision corner 800 feet East and 1000 feet North from SW Corner, Section 10.

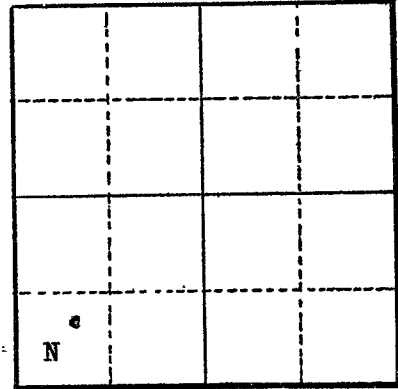

Section 10

Altitude at well _____

TYPE OF WELL: drilled Date Constructed 6-15-60

Depth drilled 20 feet Depth cased 20 feet

CASING RECORD:

4-inch casing set from 0 to 20 feet

FINISH:

slotted from 14 to 20 feet

AQUIFERS:

WATER LEVEL:

14 feet

PUMPING EQUIPMENT: Type Berkeley 5" Centrifugal H.P. _____
Capacity 1000 G.P.M.

WELL TESTS:

Drawdown ? ft. after _____ hours 1000 G.P.M.
Drawdown _____ ft. after _____ hours _____ G.P.M.

USE OF WATER Irrigation Temp. _____ °F. _____, 19 _____

SOURCE OF INFORMATION GR-4018

DRILLER or DIGGER _____

ADDITIONAL DATA:

Log (NA) Water Level Measurements _____ Chemical Analysis _____ Aquifer Test _____

REMARKS: