

STATE ENGINEER
Salem, Oregon

LANE
7894


Well Record

STATE WELL NO. 16/4W-10P
COUNTY Lane
APPLICATION NO. GR-3563

OWNER: Holly Templeton
MAILING ADDRESS: 995 Hayes Lane

LOCATION OF WELL: Owner's No.
CITY AND STATE: Junction City, Oregon

SE 1/4 SW 1/4 Sec. 10 T. 16 N. S. R. 4 W., W.M.
Bearing and distance from section or subdivision
corner 860' N. and 30' W. of S 1/4 corner Sec. 10

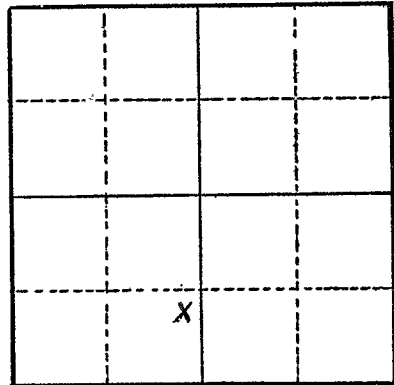

Section 10

Altitude at well

TYPE OF WELL: Driven Date Constructed 1947

Depth drilled 25 feet Depth cased 21 feet

CASING RECORD:

4 inch casing set to 21 feet

FINISH:

AQUIFERS:

Gravel

WATER LEVEL:

14 feet below surface

PUMPING EQUIPMENT: Type Rainflo centrifugal H.P. 10
Capacity 280 G.P.M.

WELL TESTS:

Drawdown ft. after hours 280 G.P.M.
Drawdown ft. after hours G.P.M.

USE OF WATER Irrigation Temp. °F. 19

SOURCE OF INFORMATION Well Registration Statement

DRILLER or DIGGER

ADDITIONAL DATA:

Log Water Level Measurements Chemical Analysis Aquifer Test

REMARKS:

Log:
Gravel