

STATE ENGINEER
Salem, Oregon

LANE
7895

Well Record


STATE WELL NO. 16S/4W-10P
COUNTY LANE
APPLICATION NO. GR-2322

OWNER: Carrol Johnson MAILING ADDRESS: 620 Hayes Lane

LOCATION OF WELL: Owner's No. #1 CITY AND STATE: Junction City, Oregon

SE $\frac{1}{4}$ SW $\frac{1}{4}$ Sec. 10 T. 16 N. S., R. 4 N. W., W.M.

Bearing and distance from section or subdivision corner 515' N. and 352' W.

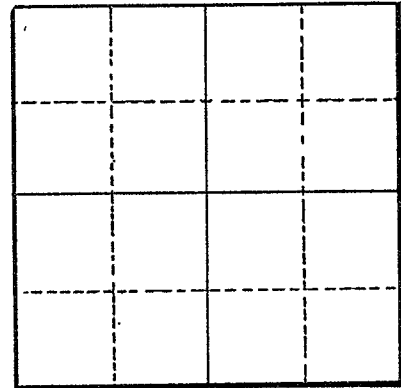

Section _____

Altitude at well _____

TYPE OF WELL: Driven Date Constructed 1940

Depth drilled 27 Depth cased 27

CASING RECORD:

4-inch

FINISH:

AQUIFERS:

Sand and gravel

WATER LEVEL:

13-Feet

PUMPING EQUIPMENT: Type Centrifugal 2" H.P. 15
Capacity 360 G.P.M.

WELL TESTS:

Drawdown _____ ft. after _____ hours _____ G.P.M.
Drawdown _____ ft. after _____ hours _____ G.P.M.

USE OF WATER Irrigation Temp. _____ °F. _____, 19____

SOURCE OF INFORMATION GR-2211

DRILLER or DIGGER _____

ADDITIONAL DATA:

Log Water Level Measurements _____ Chemical Analysis _____ Aquifer Test _____

REMARKS:

Sand and gravel