

STATE ENGINEER
Salem, Oregon

LANE
78916

Well Record

STATE WELL NO. 16/4W-10R
COUNTY LANE
APPLICATION NO. GR-1656

OWNER: Ralph C. Templeton


MAILING ADDRESS: 995 Hayes Lane

LOCATION OF WELL: Owner's No.

CITY AND STATE:

SE 1/4 SE 1/4 Sec. 10 T. 16 S., R. 4 W., W.M.

Bearing and distance from section or subdivision corner 660' W & 1120' N of SW corner Sec 10

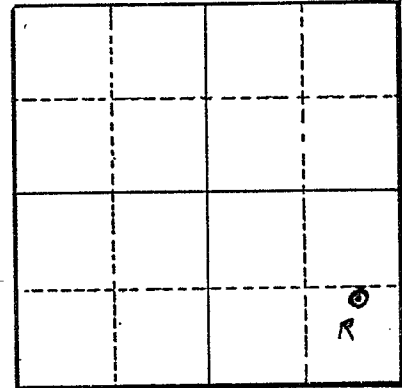

Section 10

Altitude at well

TYPE OF WELL: Dug Date Constructed 1938

Depth drilled 12' Depth cased 12'

CASING RECORD:

48'

FINISH:

AQUIFERS:

Gravel

WATER LEVEL:

8'

PUMPING EQUIPMENT: Type Pacific Centrifugal H.P. 6

Capacity 250 G.P.M.

WELL TESTS:

Drawdown 1 ft. after 250 hours G.P.M.

Drawdown ft. after hours G.P.M.

USE OF WATER Irrigation Temp. °F., 19

SOURCE OF INFORMATION GR-3852

DRILLER or DIGGER NA

ADDITIONAL DATA:

Log NA Water Level Measurements Chemical Analysis Aquifer Test

REMARKS: