

STATE ENGINEER
Salem, Oregon

LANE
7907

Well Record


STATE WELL NO. 16/LW-11F (1)
COUNTY Lane
APPLICATION NO. GR-538

OWNER: A. L. Detering MAILING ADDRESS: _____

LOCATION OF WELL: Owner's No. #3 CITY AND STATE: Harrisburg, Ore.

SE $\frac{1}{4}$ NW $\frac{1}{4}$ Sec. 11 T. 16 S., R. 4 W., W.M.

Bearing and distance from section or subdivision corner S. 27° 18' E. 29.96 ch. from S.W. cor.
DLC #56

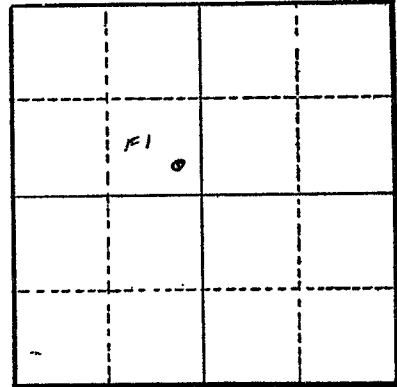

Section 11

Altitude at well 340

TYPE OF WELL: driven Date Constructed May, '42

Depth drilled 20 Depth cased 20

CASING RECORD:

3" & 4" casings - 2 ft. apart.

FINISH:

AQUIFERS:

WATER LEVEL:

10 ft.

PUMPING EQUIPMENT: Type Centrifugal H.P. 20
Capacity 450 G.P.M.

WELL TESTS:

Drawdown 3 ft. after _____ hours 400 G.P.M.
Drawdown _____ ft. after _____ hours _____ G.P.M.

USE OF WATER irrigation - 41.8 Temp. _____ °F. _____, 19

SOURCE OF INFORMATION GR-538

DRILLER or DIGGER Nelson; Junction City, Ore.

ADDITIONAL DATA:

Log --- Water Level Measurements _____ Chemical Analysis _____ Aquifer Test _____

REMARKS: